


"There is a five foot utility and drainage easement along all side and rear lot lines. There is a 10 foot easement along creek."

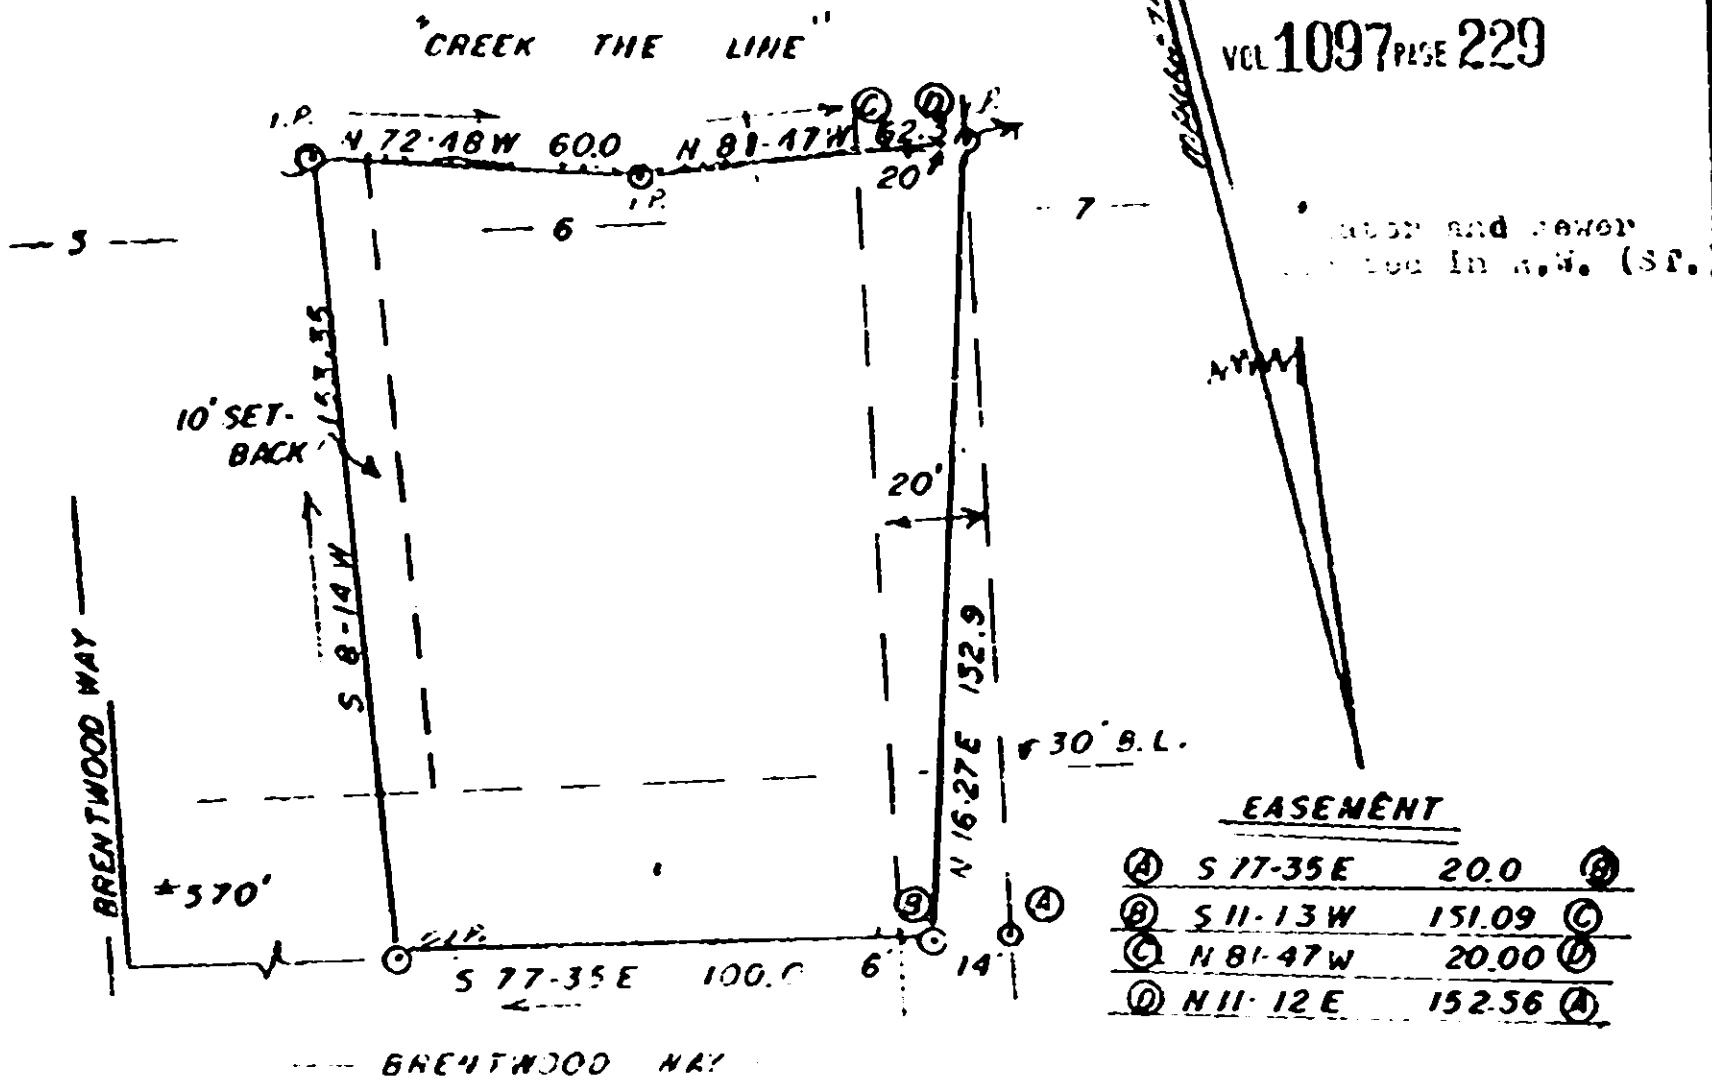

* THE ABOVE ILLUSTRATION REPRESENTS A PROPOSED REALIGNMENT AND WIDTH REVISION OF SEWER RIGHT OF WAY ALONG BOUNDARY OF LOTS NOS. 6 8 7.

21151

Scale 1"=10'			APPROVED BY			DRAWN BY		
DATE 12-11-77			REVISION			REVISION		
Drawn from water plat by [unclear] and [unclear] May 19, 1977 - BRENTWOOD SEWER CO.								
Morgantown, W. Va. Morgantown, W. Va.						DRAWING NUMBER		
						77-1-19		

RECORDED FEB 21 1978
at 2:21 P.M.

BR 220

4000 RV-2