


LIMITED COMMON ELEMENTS

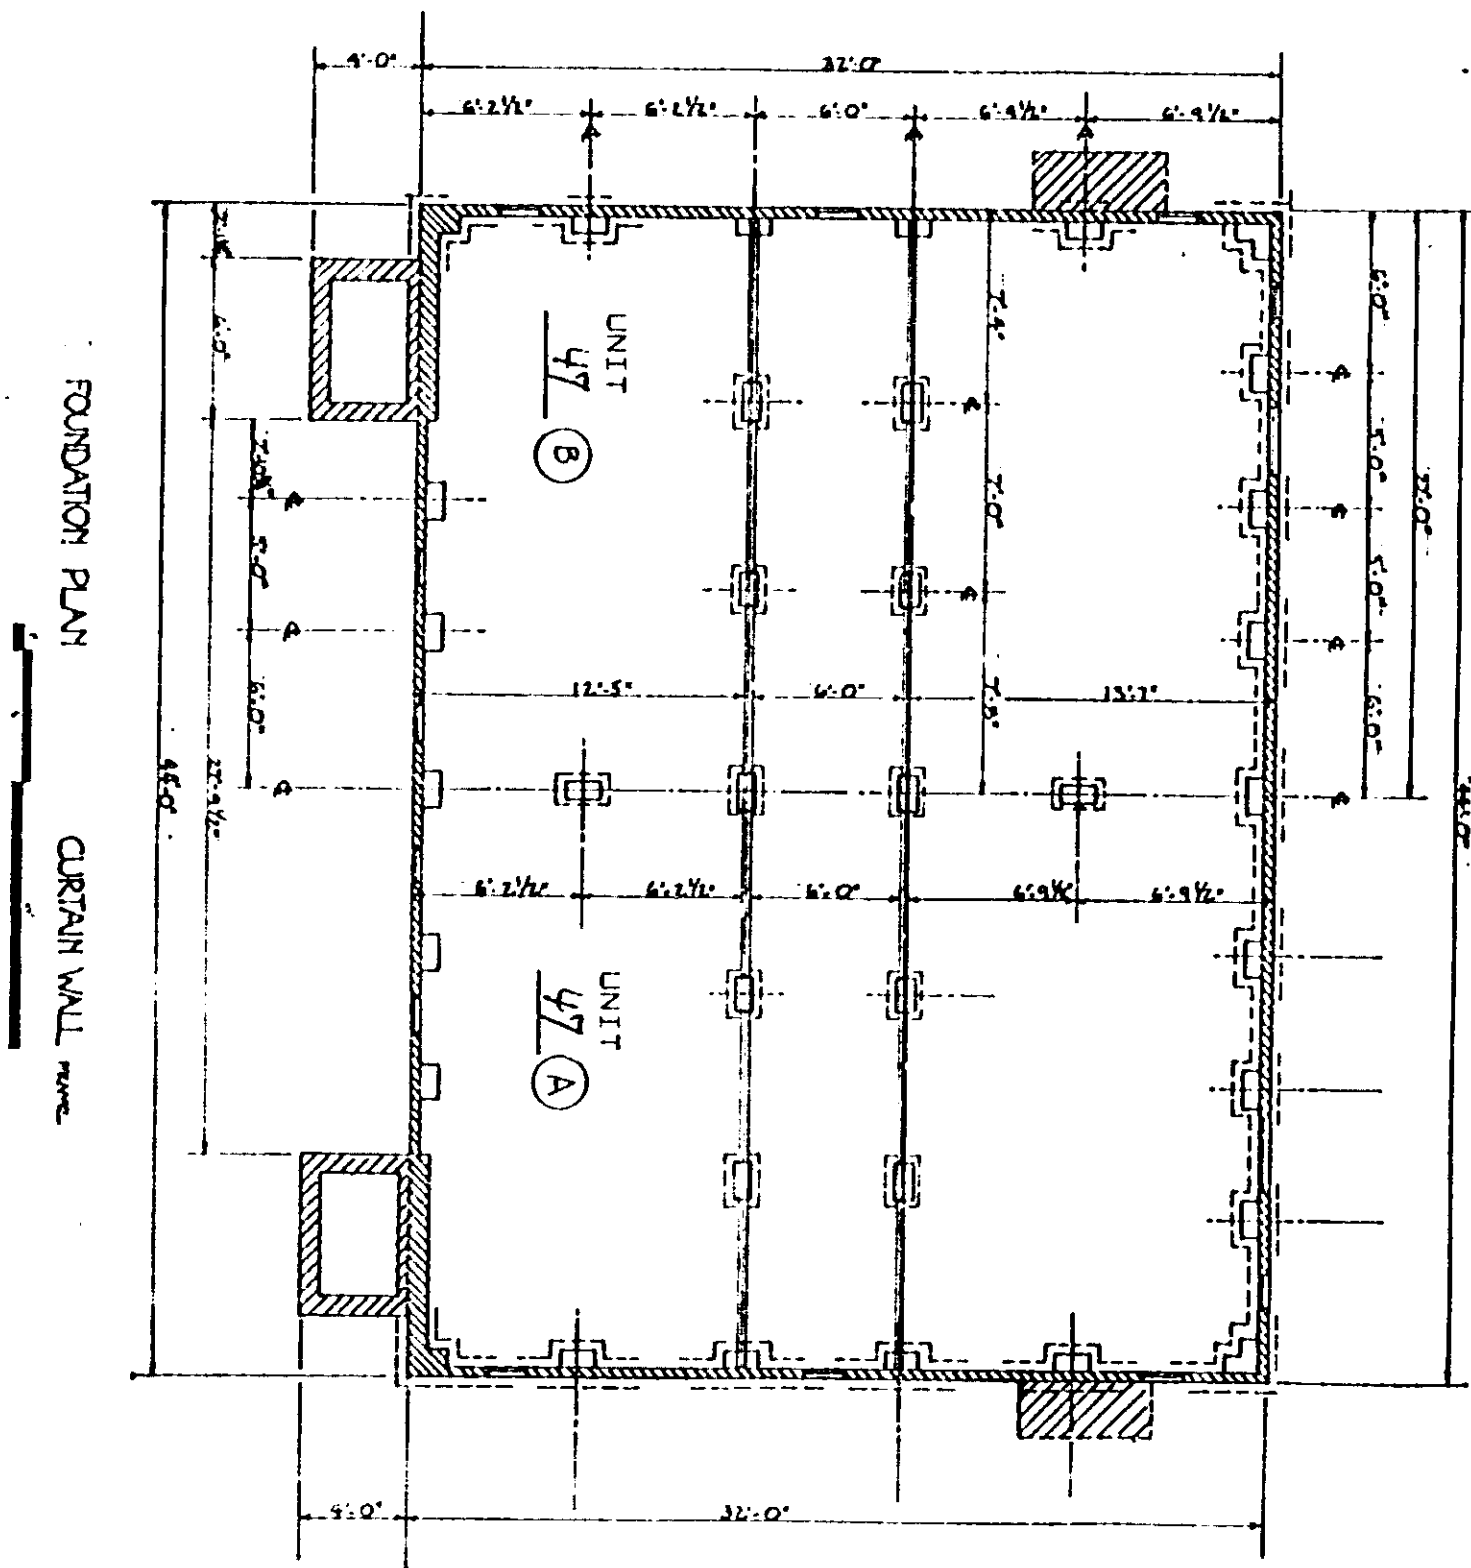

FOUNDATION PLAN  
CURTAIN WALL

CERTIFICATE

I, Wade H. Barber, do hereby certify that these plans fully depict within reasonable construction tolerances the layout, location, letter identification and dimensions of the buildings and dwellings contained therein.

Wade H. Barber

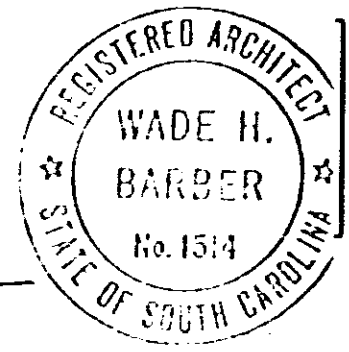


Exhibit A

0217

4328 RV-2