


LIMITED COMMON ELEMENTS

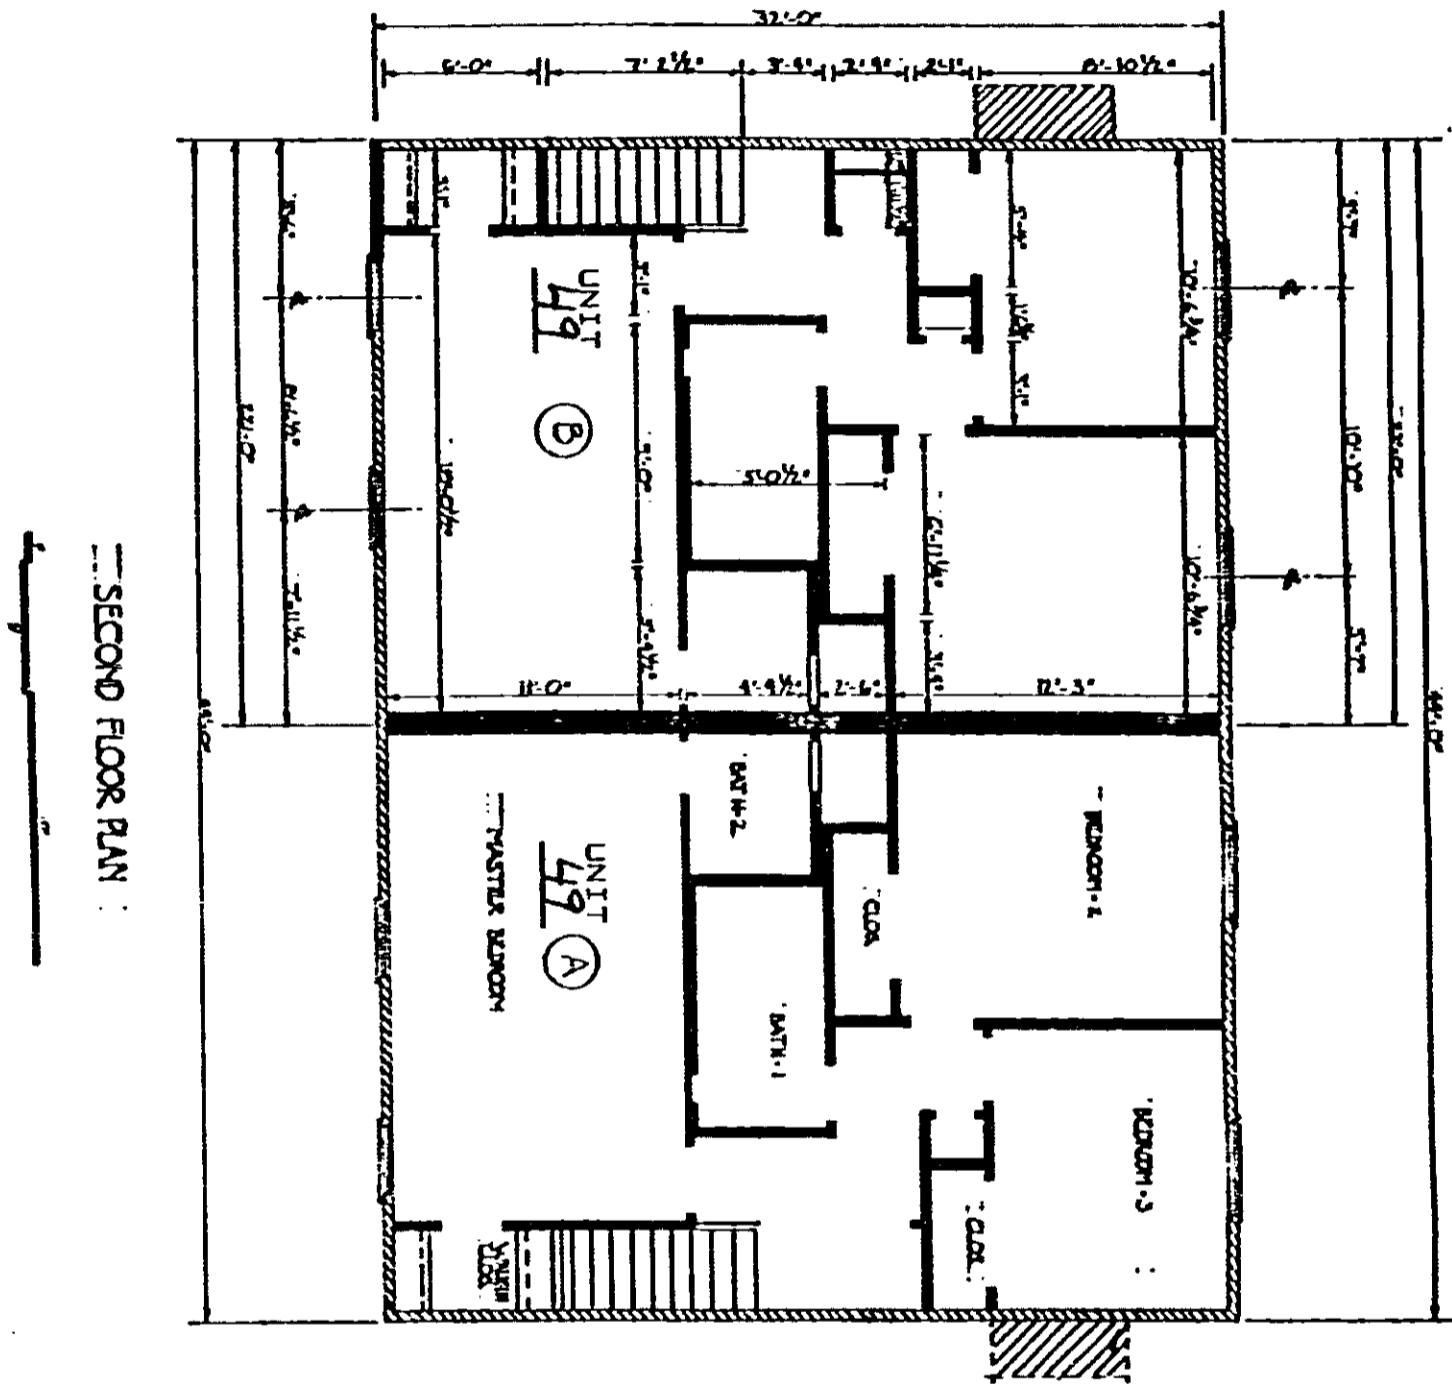


SECOND FLOOR PLAN

CERTIFICATE

I, Wade H. Barber, do hereby certify that these plans fully depict within reasonable construction tolerances the layout, location, letter identification and dimensions of the buildings and dwellings contained therein.

Exhibit A

Wade H. Barber

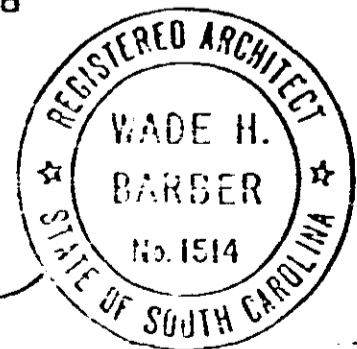

0279

4328 RV-2