

1103-710

State and
Post Office Address
of Grantor

MRS MINNIE LEE HARPER

ROUTE 5
PIEDMONT, S.C.

Toll

Line

or

Exchange Line

tributary to

GREENVILLE, S.C.

(Exchange)

The property is bounded where the line enters and leaves this property by the property of

BENTWOOD SUBD on the NORTH

and S.C. ROAD 143 on the WEST

Authority 33-2132 Classification R45C




Area GREENVILLE, S.C.

Appointed J. D. Tyler

Dist. Atg. Distribution

NORTH

BENTWOOD SUBDIVISION

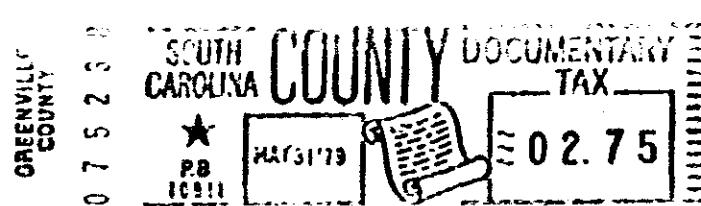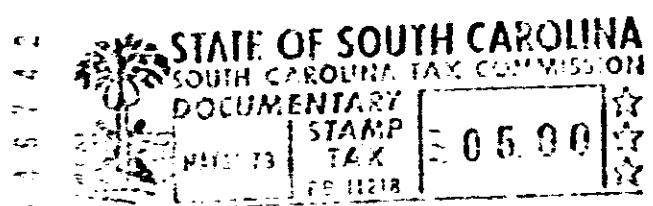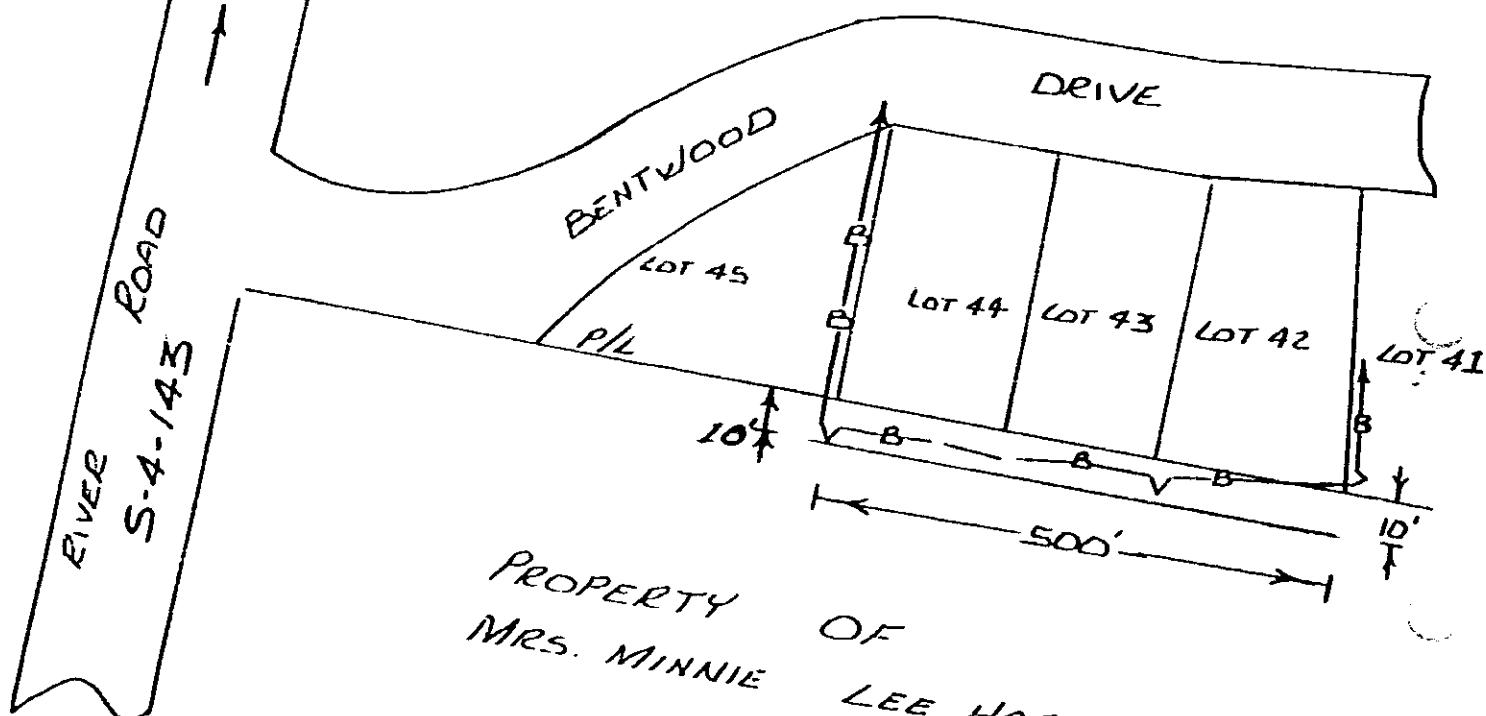

RECORDED MAY 31 1979

at 2:25 P.M.

35335

Filed for record in the office of
the R. M. C. for Greenville
County, S. C. At 2:25 o'clock
P.M. May 31, 1979
and recorded in Deed Book
1103 at page 715

R. M. C. for G. Co. S. C.

4328 RW-2