


EXHIBIT C

VOL 1108 PAGE 845

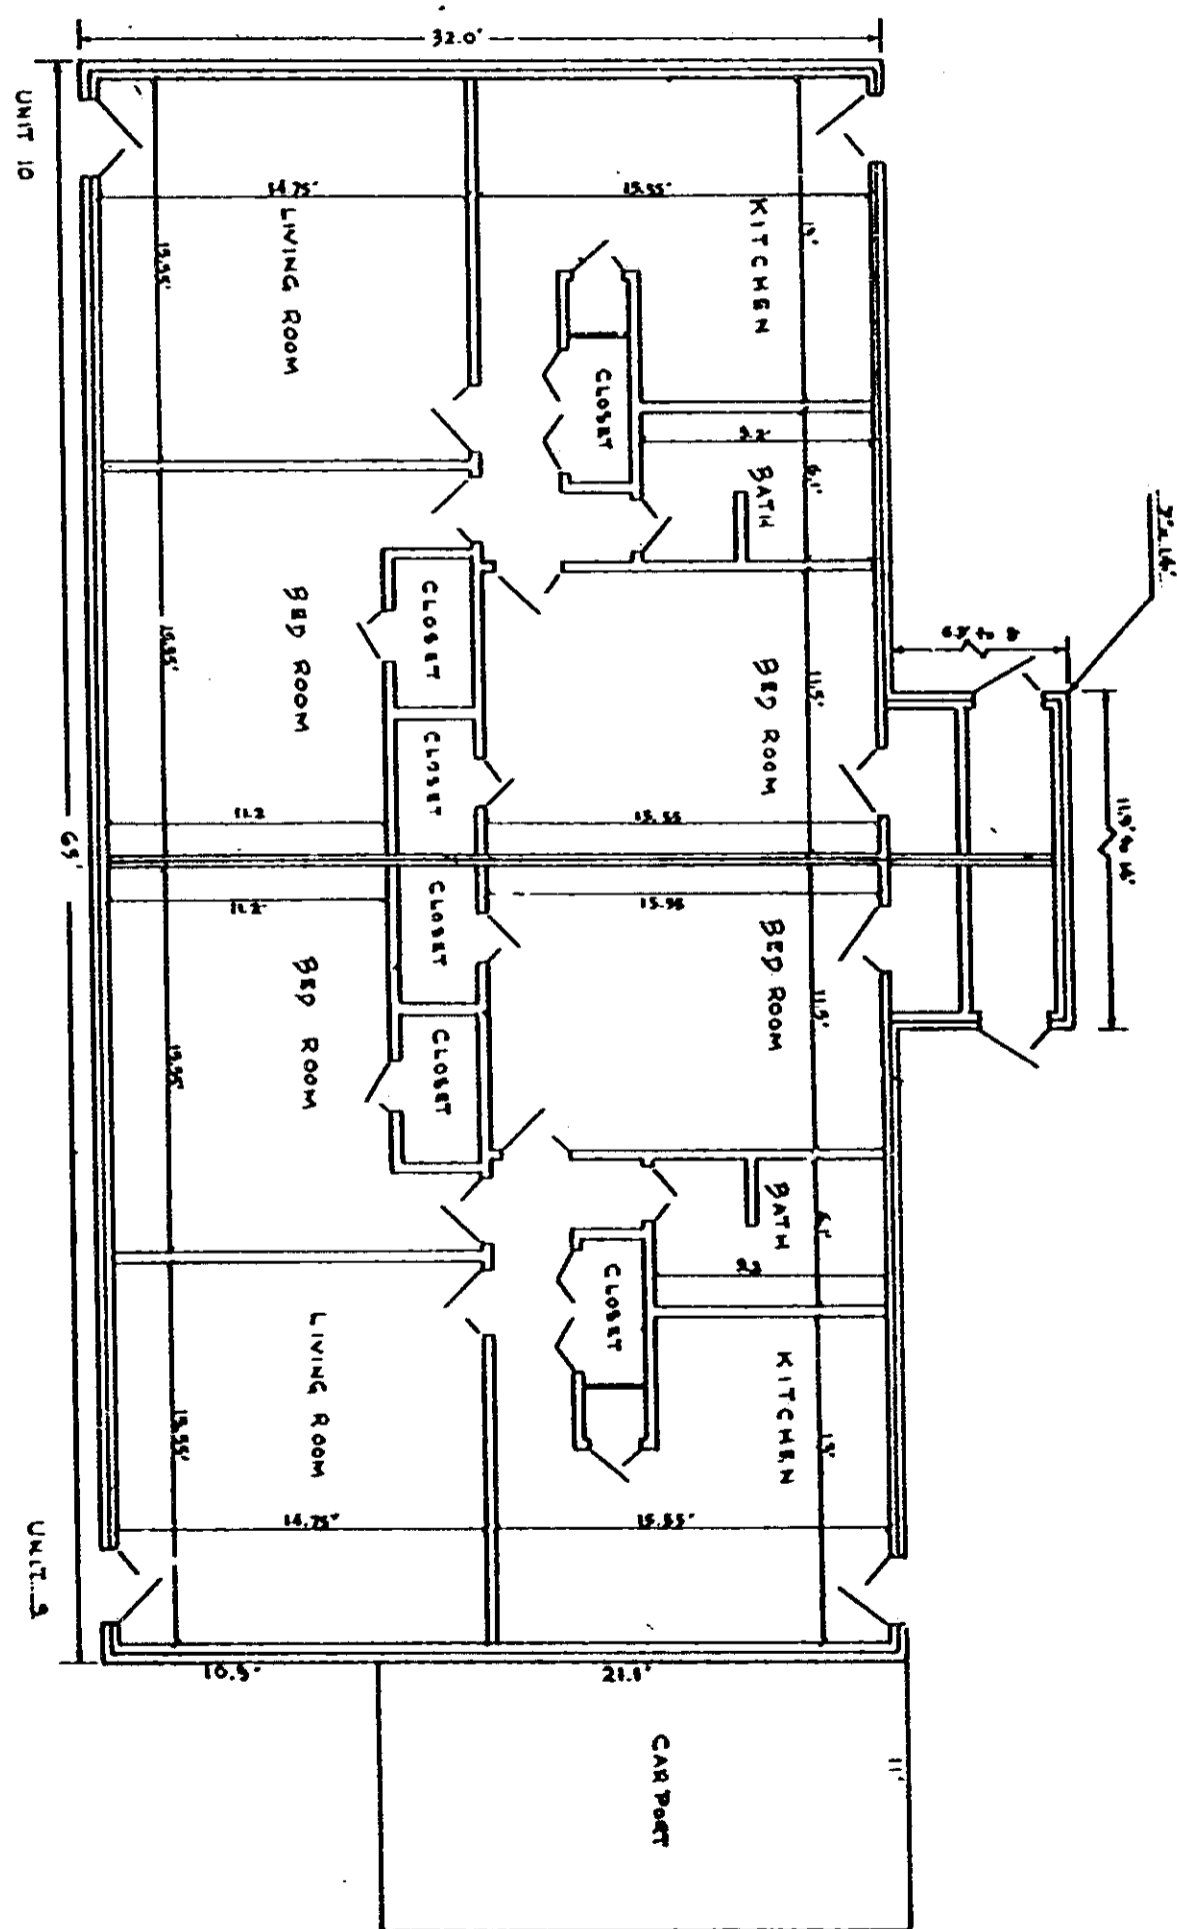

FLOOR PLAN

THIS IS TO CERTIFY THAT THIS FLOOR PLAN WAS DRAWN BY ME AS AN ACTUAL FIELD MEASUREMENT AT PALMER COUNTY.



0845

4328 RV-2