

A. THESE PLANS PERTAIN TO BUILDING 1A, 2A

B. THE BUILDING SHOWN IN THIS PLAN CONSISTS OF ONE 2 BEDROOM TOWNHOUSE

EACH UNIT CONSISTS OF THE SPACE BOUNDED BY THE UNDERCOATED AND/OR UNFINISHED SURFACES OF THE PERIMETER, FLOORS, WALLS AND CEILINGS.

UNLESS MARKED ALL INTERIOR AND EXTERIOR ANGLES ARE 90 DEGREES.


C. ARCHITECT'S CERTIFICATE:

I HEREBY CERTIFY THAT, TO THE BEST OF MY KNOWLEDGE, THE INFORMATION SHOWN IS TRUE, AND CORRECT.

JOE W. HILLER, AIA - S.C. REG. NO. 658

D. LEGEND:

BOUNDARY OF UNIT	-----	-----
LIMITED COMMON ELEMENT	-----	-----
INTERIOR LOAD BEARING PARTITION	-----	-----

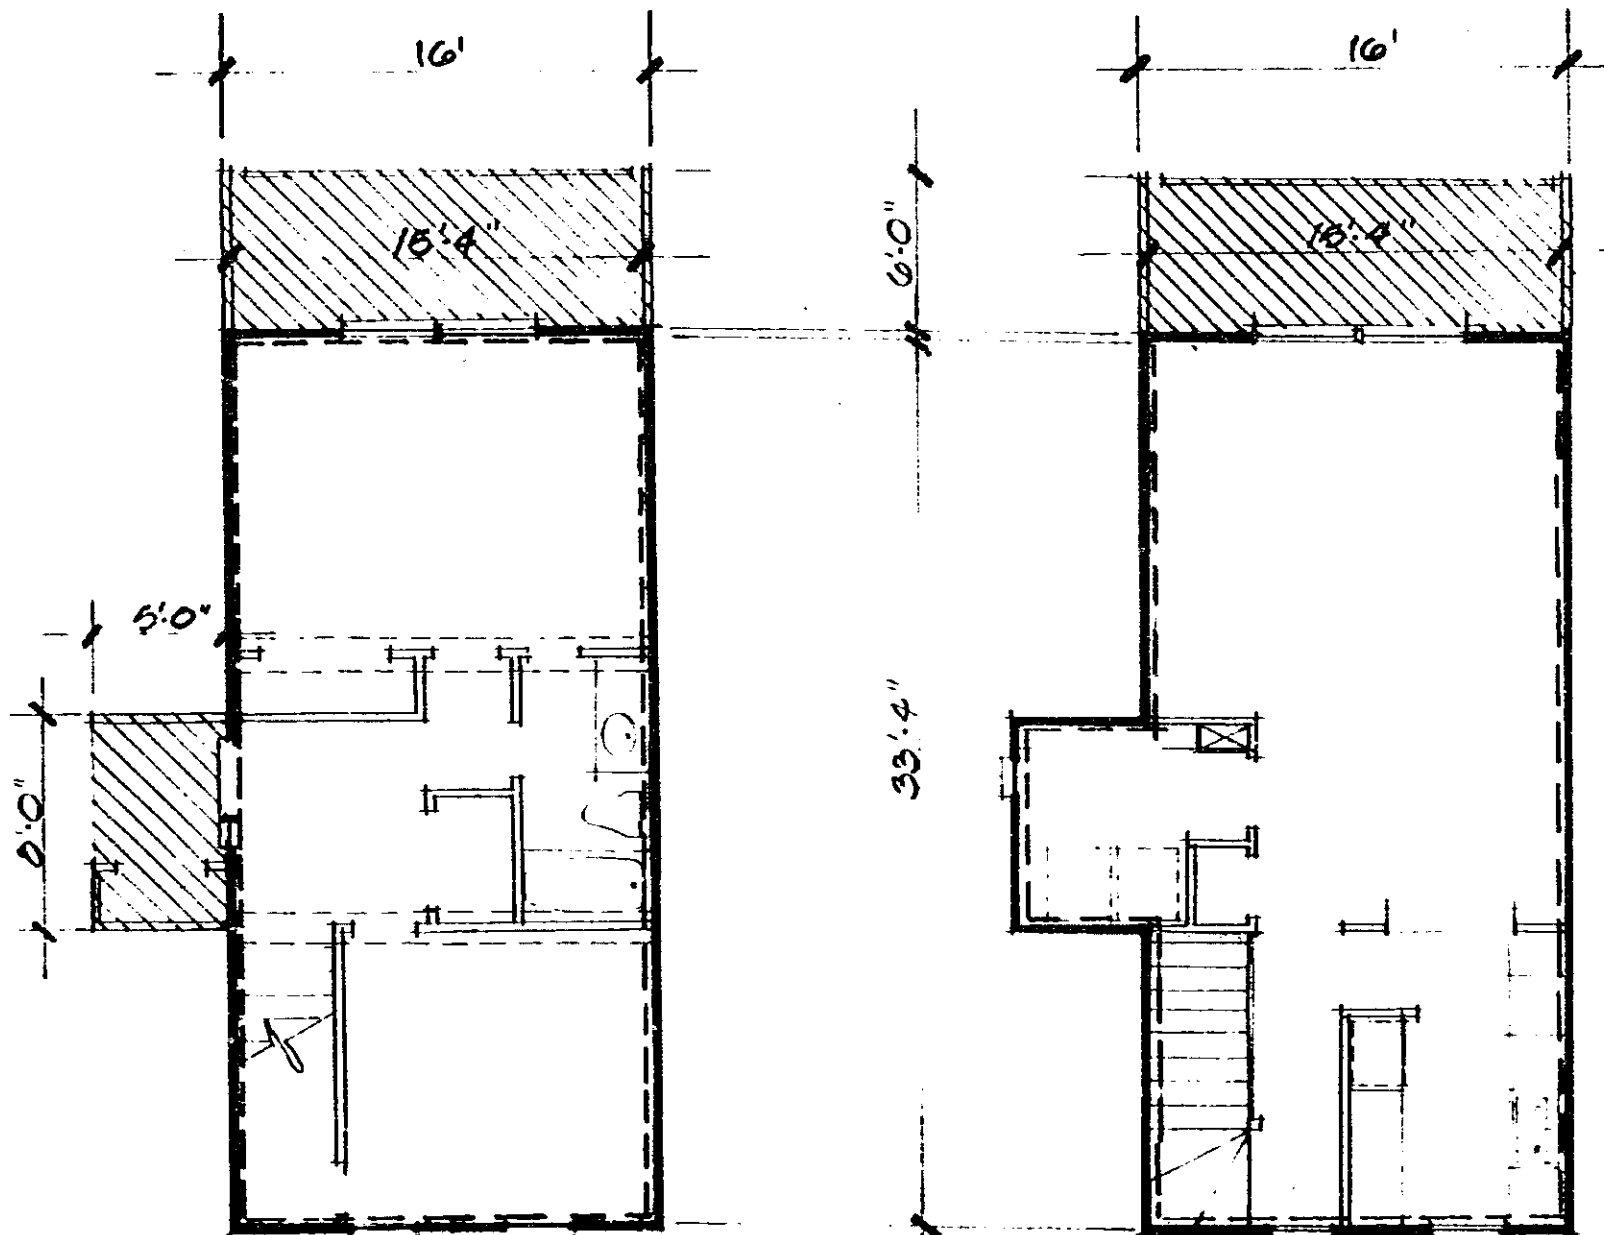

FIRST FLOOR PLAN  
1/8" = 1'-0"  
334 #

SECOND FLOOR PLAN  
1/8" = 1'-0"  
334 #

0.284

4328 RV-2