B. THE BUILDING SHOWN IN THIS PLAN CONSISTS OF ONE 2-BEDROOM - TOWNHOUSE

EACH UNIT CONSISTS OF THE SPACE BOUNDED BY THE UNDERCOATED AND/OR UNFINISHED SURFACES OF THE PERIMETER, FLOORS, WALLS AND CEILINGS.

UNLESS MARKED ALL INTERIOR AND EXTERIOR ANGLES ARE 90 DEGREES.

C. ARCHITECT'S CERTIFICATE:

I HEREBY CERTIFY THAT, TO THE BEST OF MY KNOWLEDGE, THE INFORMATION SHOWN IS

TRUE AND CORRECT.

JOE V. HILLER, AIA = S.C. REG. NO. 658


D. LEGEND:

BOUNDARY OF UNIT

LIMITED COMMON ELEMENT

INTERIOR LOAD BEARING PARTITION



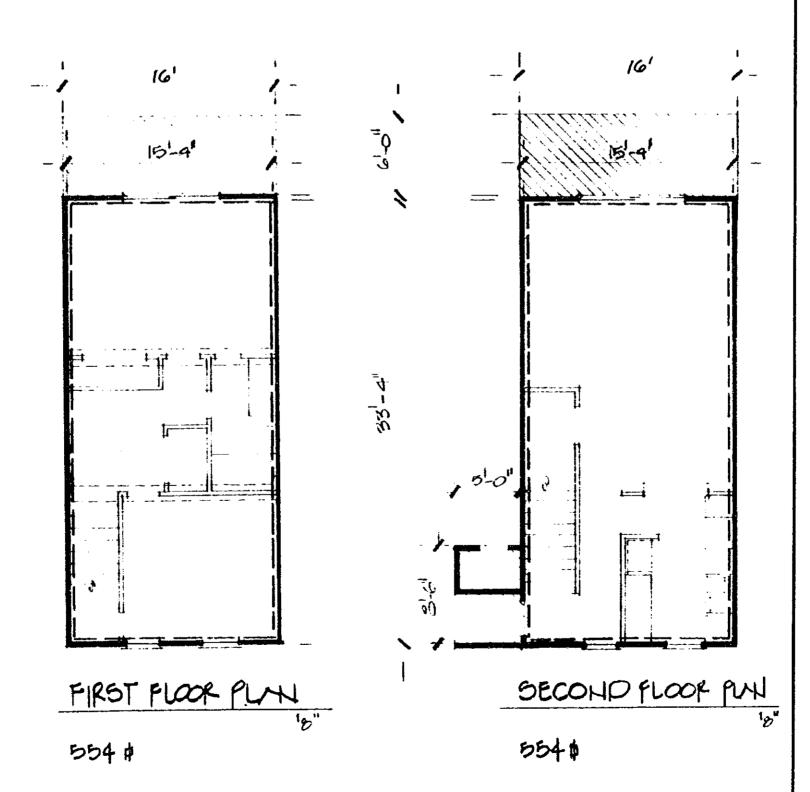

4328 RV-2