


EXHIBIT "A"

Recorded March 21, 1979 in plat book 7-B page 75

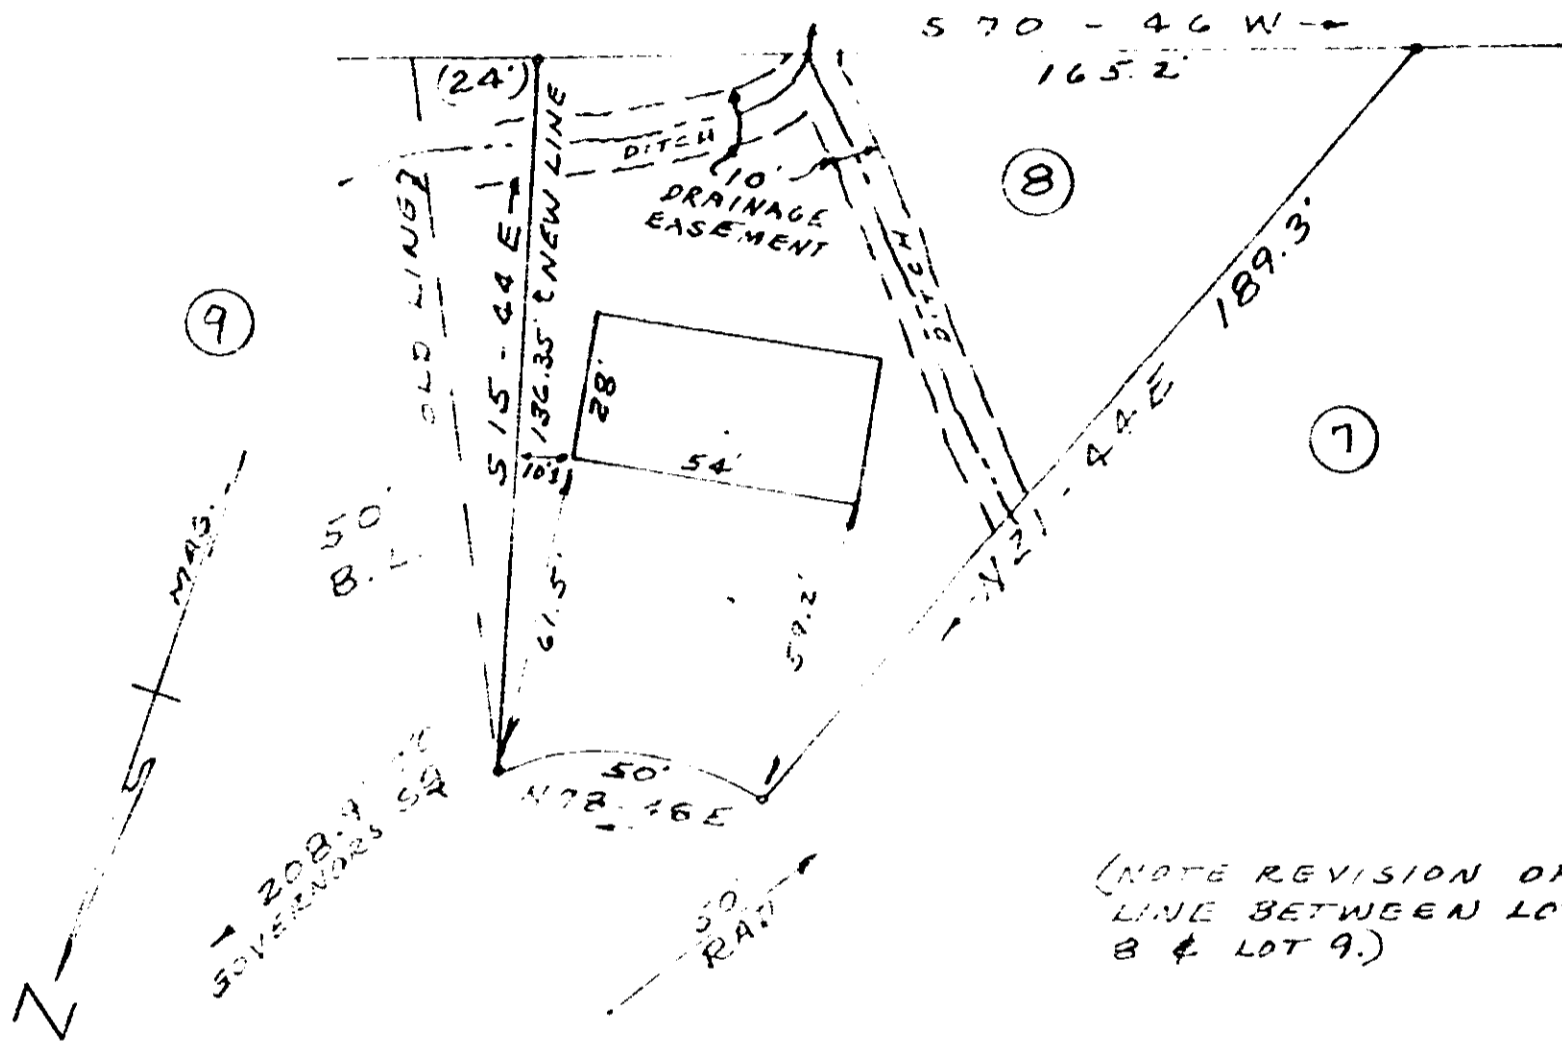

DLS
 J.P.
 E.M.C.
 J.O.T.

GOVERNORS COURT

FOUNDATION SURVEY
 LOT 8 - GOVERNORS SQUARE
 GREENVILLE CO., S.C.
 FEB 15, 1979 SCALE 1" = 40'

SURVEY BY 3rd CLARKSON SURVEYING
 200 S. ...
 GREENVILLE, S.C.

Recorded Sept 13, 1979 at 1:19 P/M

8896

0505

4328 RV-2