


CYPRESS

ST.

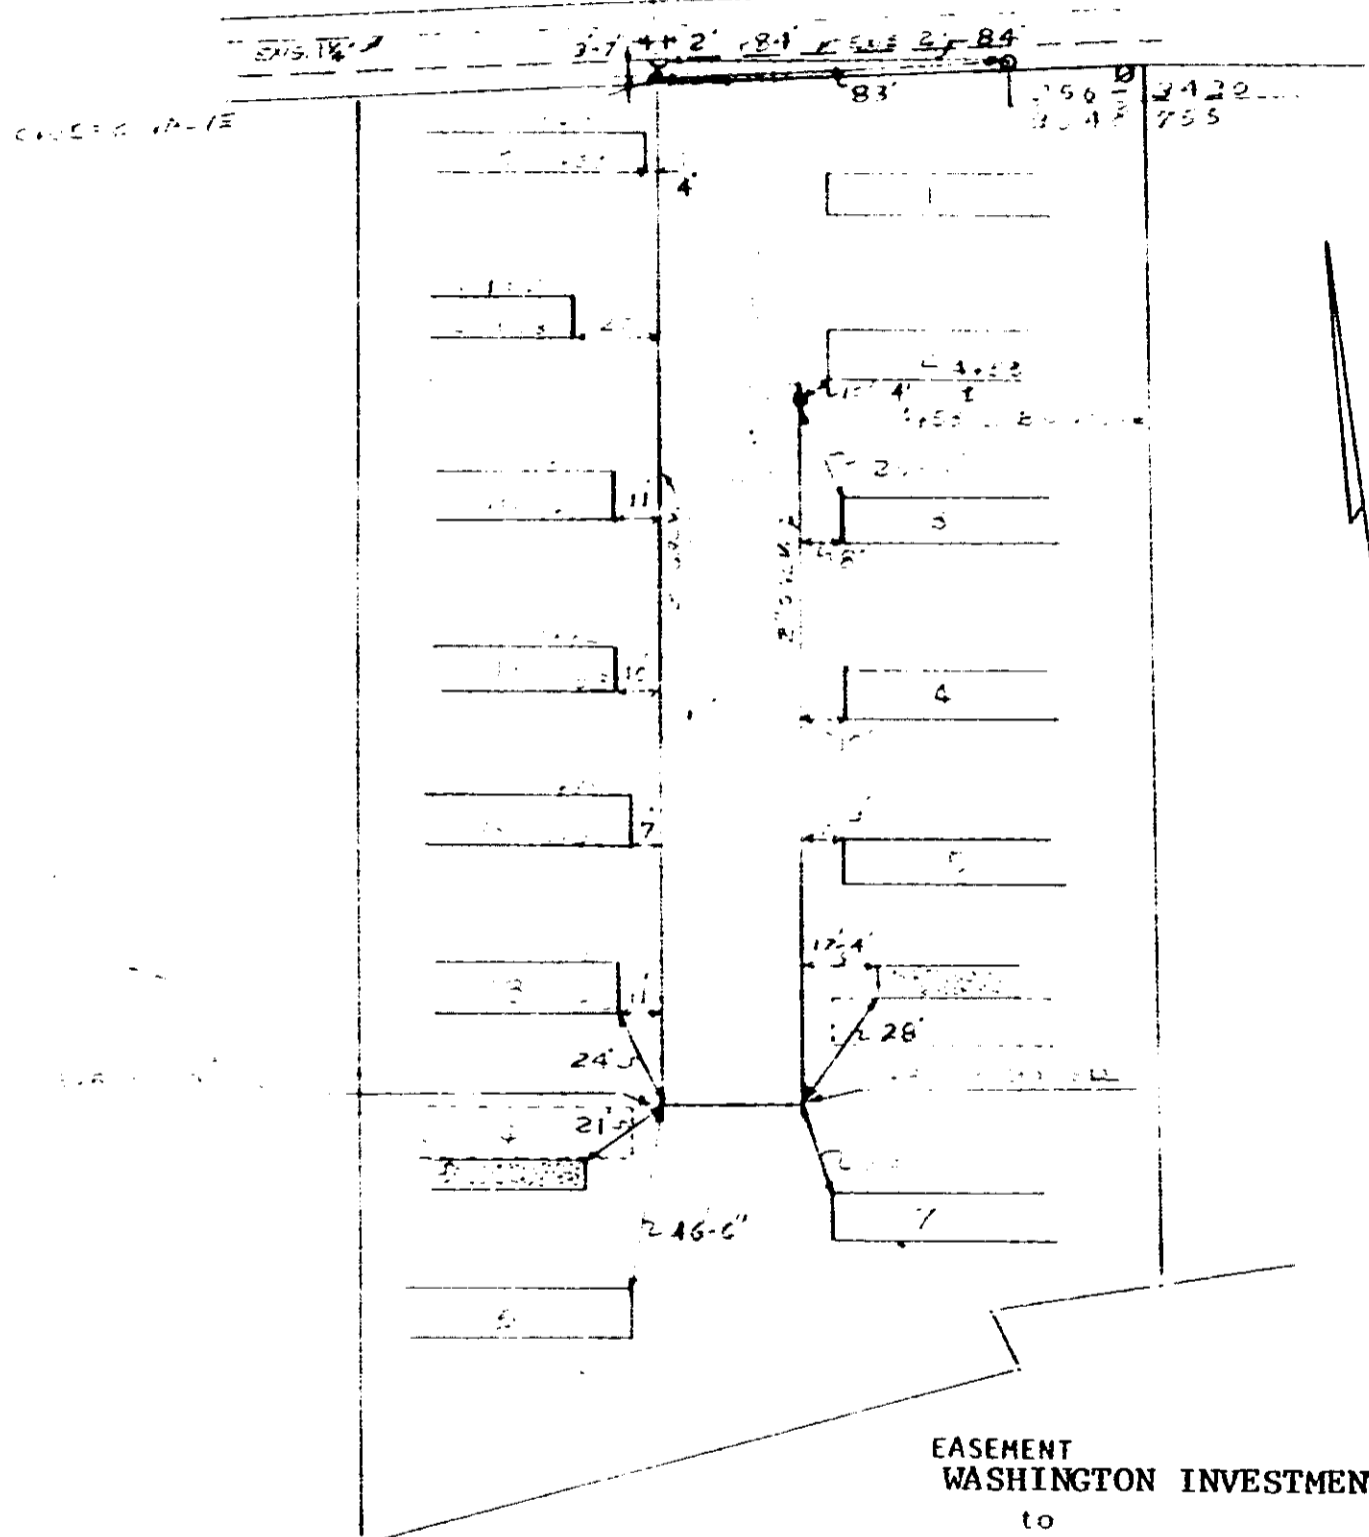

EASEMENT
 WASHINGTON INVESTMENT CO., INC.
 to
 Commissioners of Public Works
 of the City of Greenville, S. C.
 August 30, 1973

CYPRESS COURT TRAILER PARK
 SCALE 1"=50'
 BLK. BK. 183.3-1-11 JULY 1973

RECORDED SEP 14 1979
 at 4:54 P.M.

9106

0590

4328 RV-2