Buyer's initials: _____

Seller's initials: _____

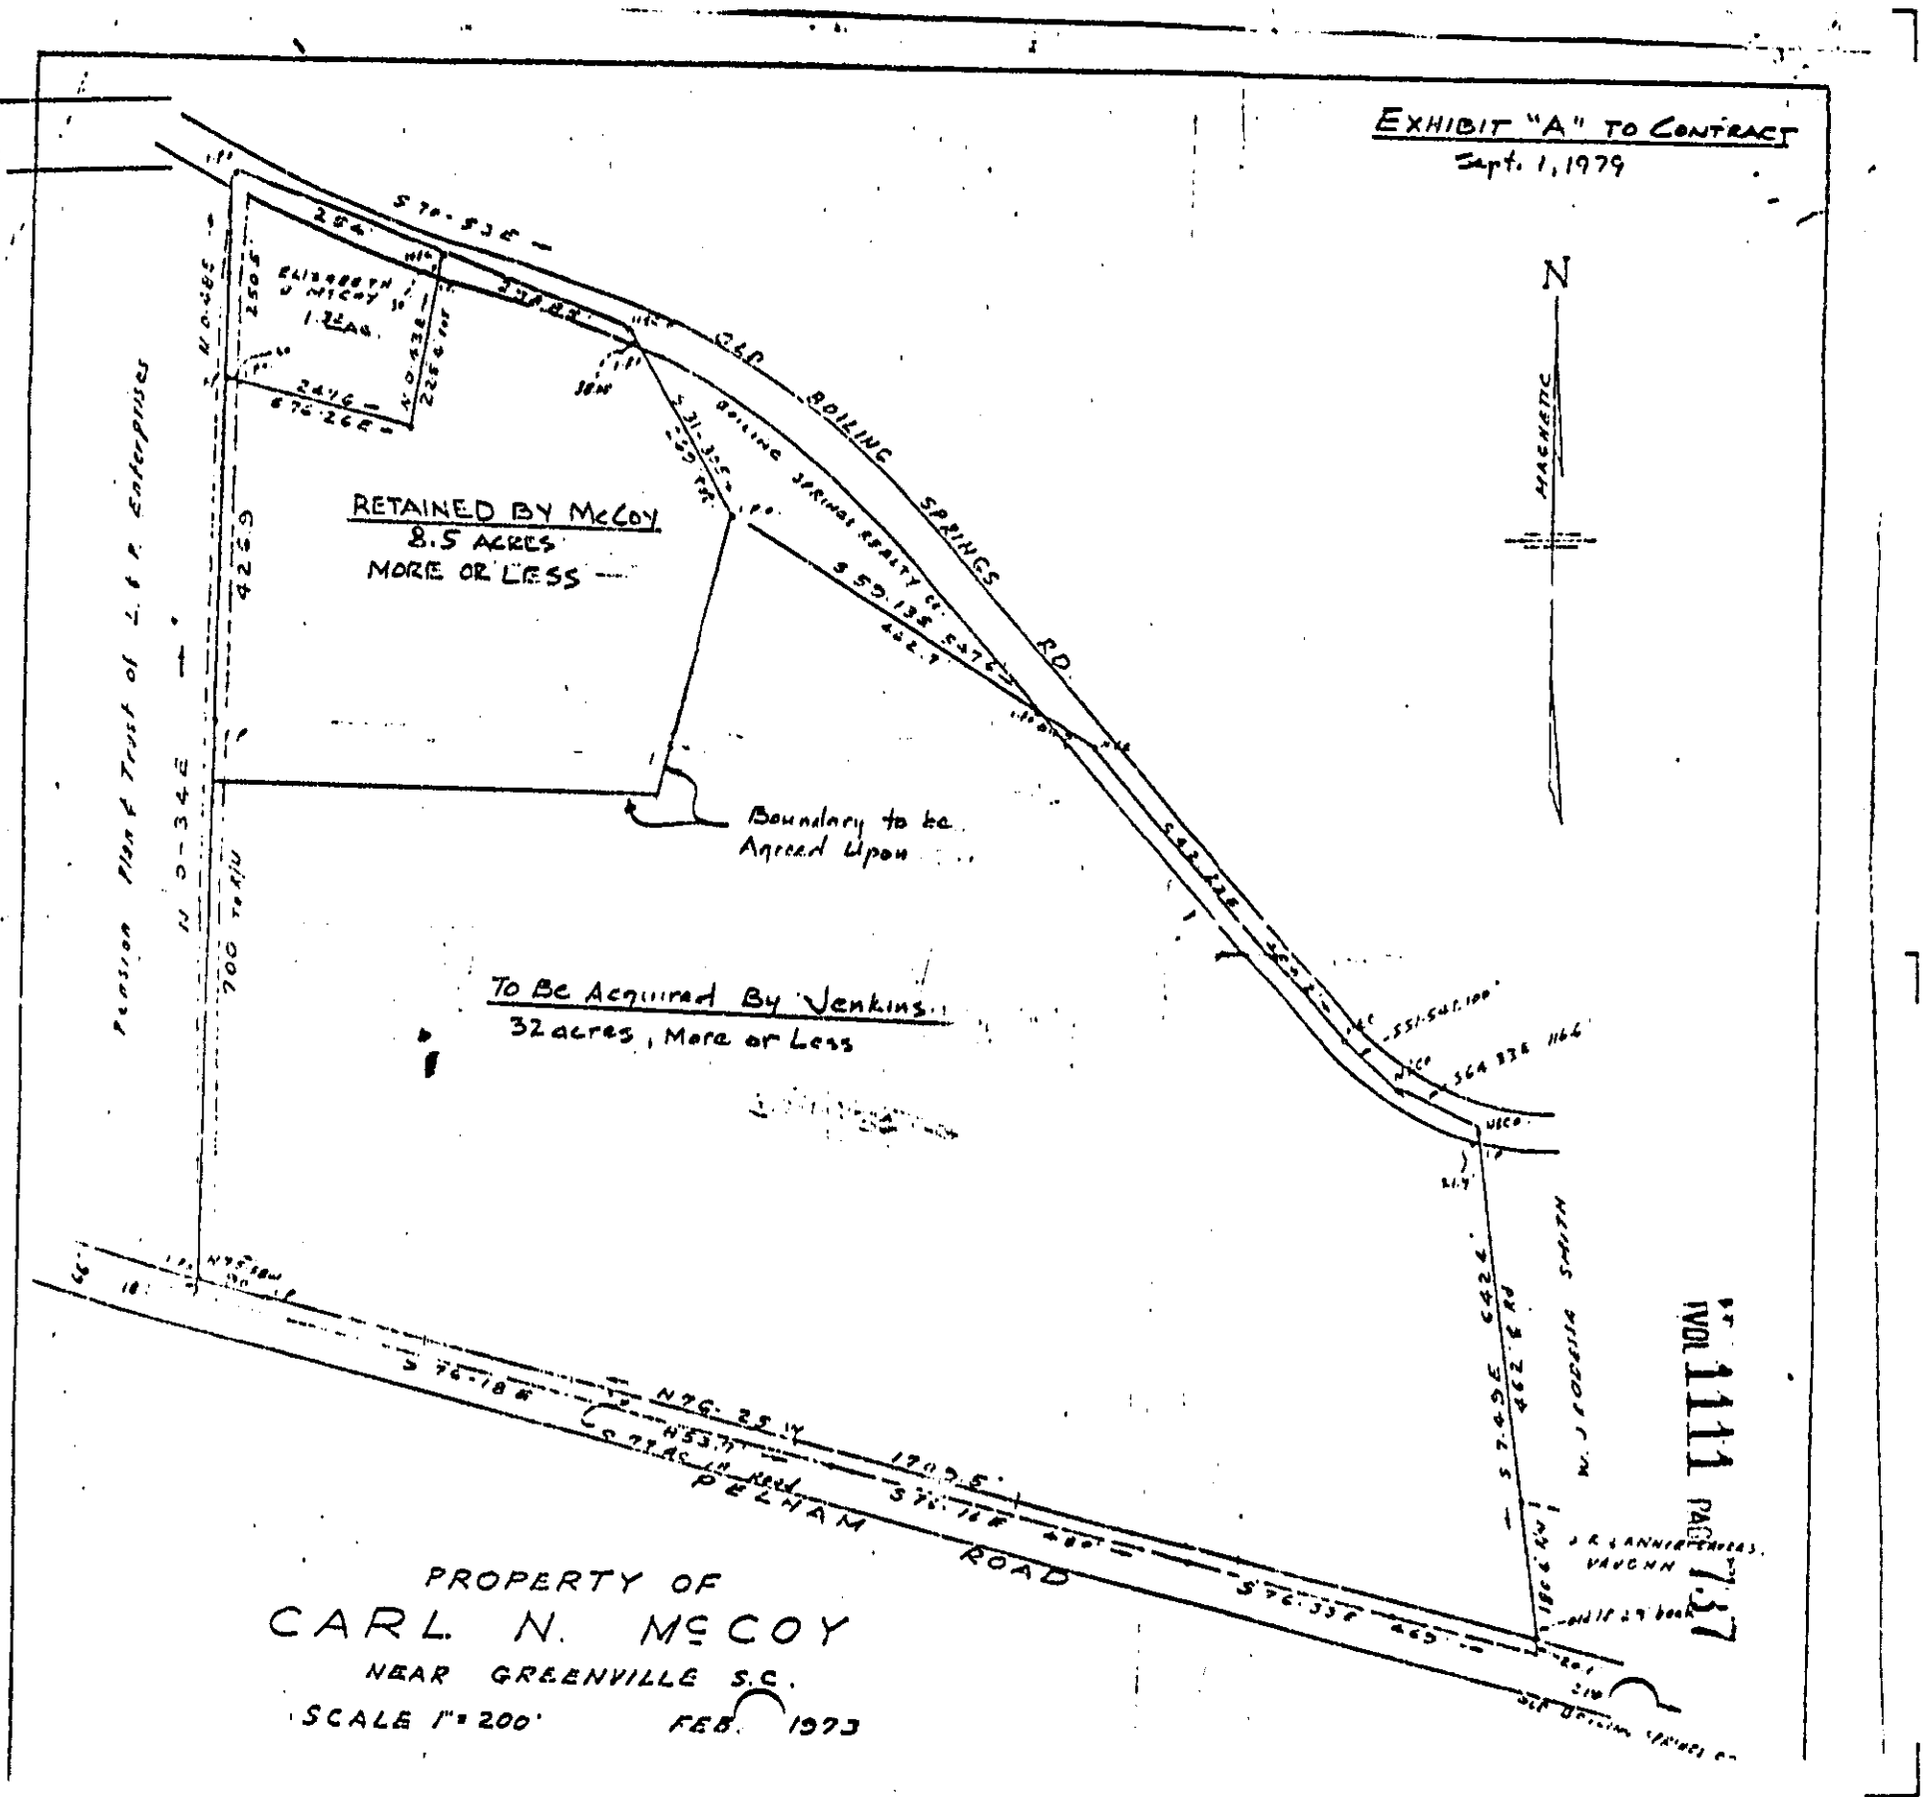

RECORDED SEP 17 1979
at 4:09 P.M.

VOL 1111 PAGE 737

9268

4328 RV-2

0 7 3