
VOL 1111 PAGE 900

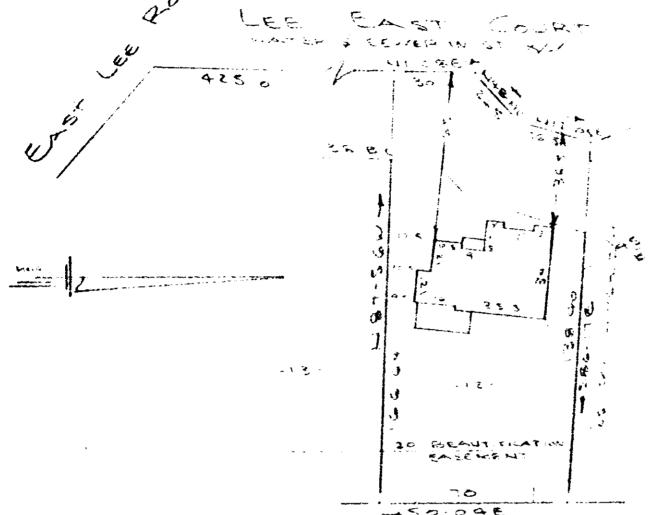

NOTA: Improvements on this lot are not in a flood hazard area.

ETOWARDS STREET

TOMI LYNN FISH
NEAR GREENVILLE, S.C.
SCALE, 17: 40 29 MAY 1979

This is to certify that on the 29th day of May, 1979, I surveyed the property shown on this plat, being known as lot 12 on plat of LME EAST and recorded in the RMC Office Greenville County, S. C., in Plat Book " 6 - H " at Page 40; and that the property lines, walls and buildings are as shown hereon, and that the walls and buildings located on said lot do not encroach or project on adjacent street or property, and that no adjacent walls or buildings encroach or project on said premises, and no power lines cross this property except as shown hereon.

R. B. Bruce, 318 #1992

RECORDET SEP 1 9 1979 at 11:03 A.M.

9596

CAROLINA SURVEYING CO 112 Manly St. Greenville, S. C.

18 35 381

1 -1 -1 PET

328 RV.2

