

Vol 1112 Page 298


Name and Address of Grantor  
WILLIAM H. MASUD  
1120 CURETOW ST.  
GREENVILLE, S.C., 29605

Name and Address of Grantee  
GREENVILLE, SOUTH CAROLINA  
(Exchange)

The Property is bounded where the line enters and leaves this property by the corners of  
ALVING COX on the SOUTH  
McCUEN ST. on the EAST  
 Authority P-43435 Classification 45-C  
SOUTH CAROLINA

Approved  
District Manager - Distribution

NOTE

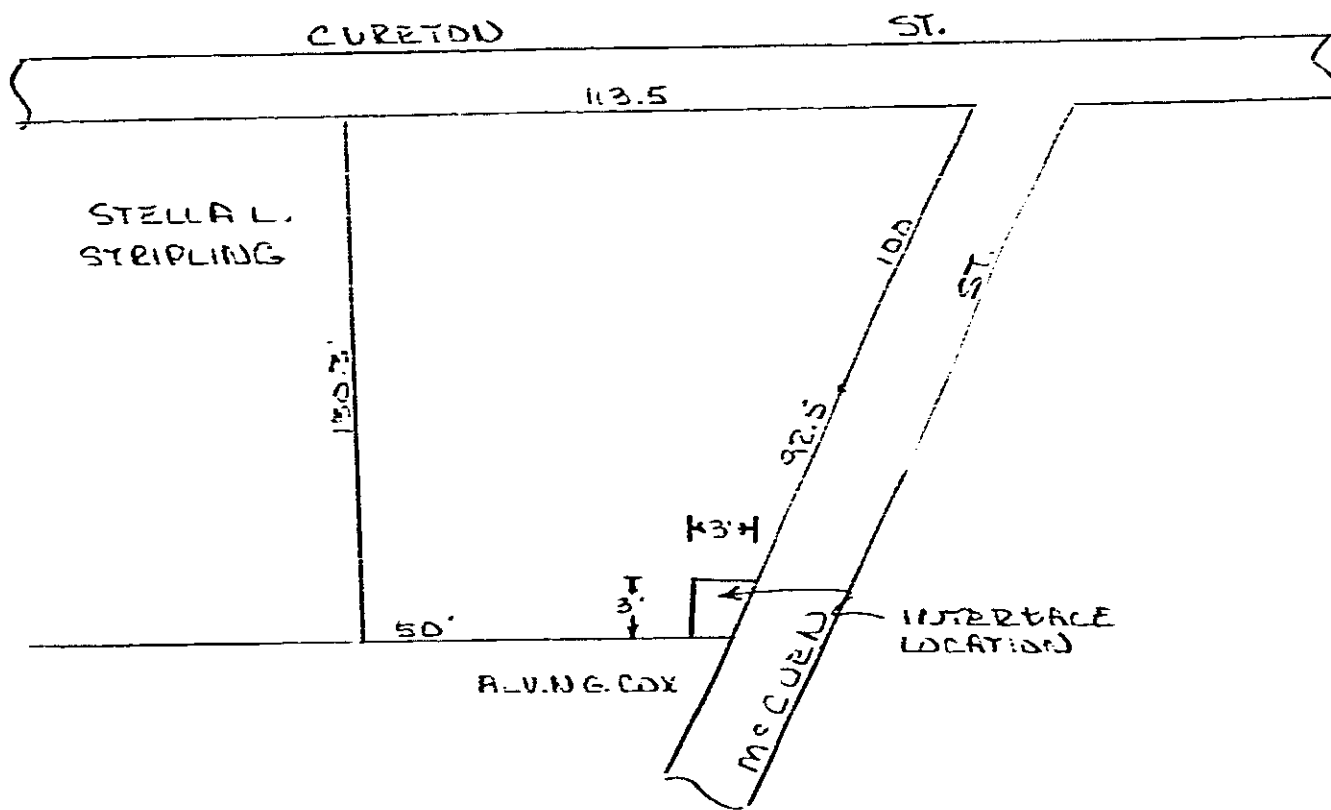

RECORDED SEP 26 1979 at 11:46 A.M.

R. M. C. for G. Co. S. C.

and recorded in Deed Book 1112 at page 297

Filed for record in the office of the R. M. C. for Greenville County, S. C. at 11:46 o'clock A.M. Sept. 26, 1979

10312

XY

SEP 26 1979

10312

4328 RV-2

REV. 10. 0.