


Name and Post Office Address of Grantor WEST MINISTER CO.  
P.O. Box 5289 STA B  
GNVL, S.C. 29602

Toll Line or Exchange Line tributary to GNVL  
(Name) (Exchange)

The Property is bounded where the line enters and leaves this property by the property of:  
WEST MINISTER CO on the NORTH  
 and WEST MINISTER CO. on the SOUTH  
 Authority P43520 Classification R45C  
 Area SOUTH CAROLINA  
 Approved \_\_\_\_\_  
 Title \_\_\_\_\_

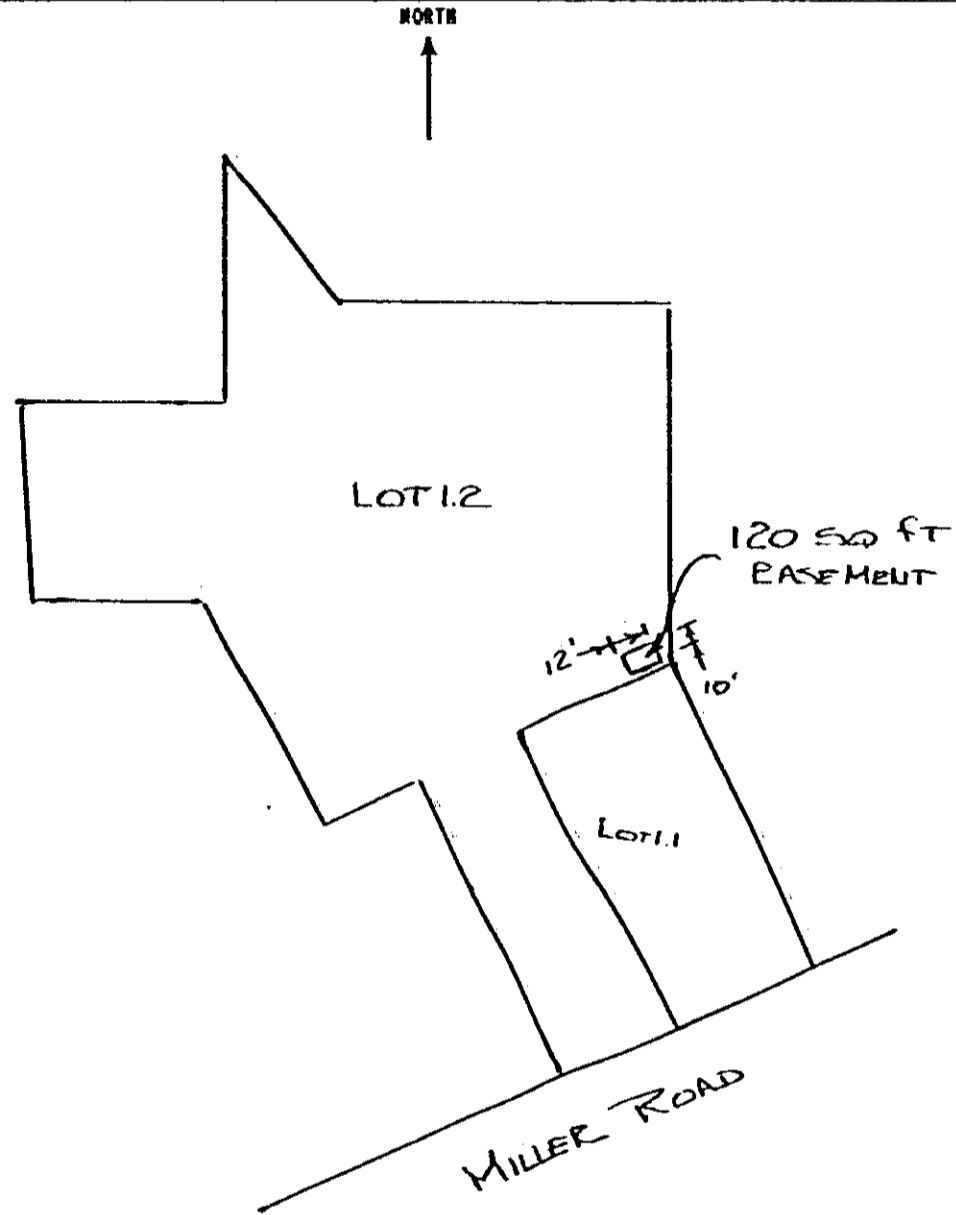

RECORDED DEC 13 1979 at 1:26 P.M.

19417

Filed for record in the office of  
 the R. M. C. for Greenville  
 county, S. C. at 1:26 o'clock  
 P.M. Dec. 13, 1979  
 and recorded in Deed Book  
 1117 at page 322  
 R. M. C. for G. Co. S. C.

DEC 13 1979  
 19417  
 R. M. C. for Greenville  
 County, S. C.

5280

2-AJ 8237