


550

BOOK 1121 PAGE 551

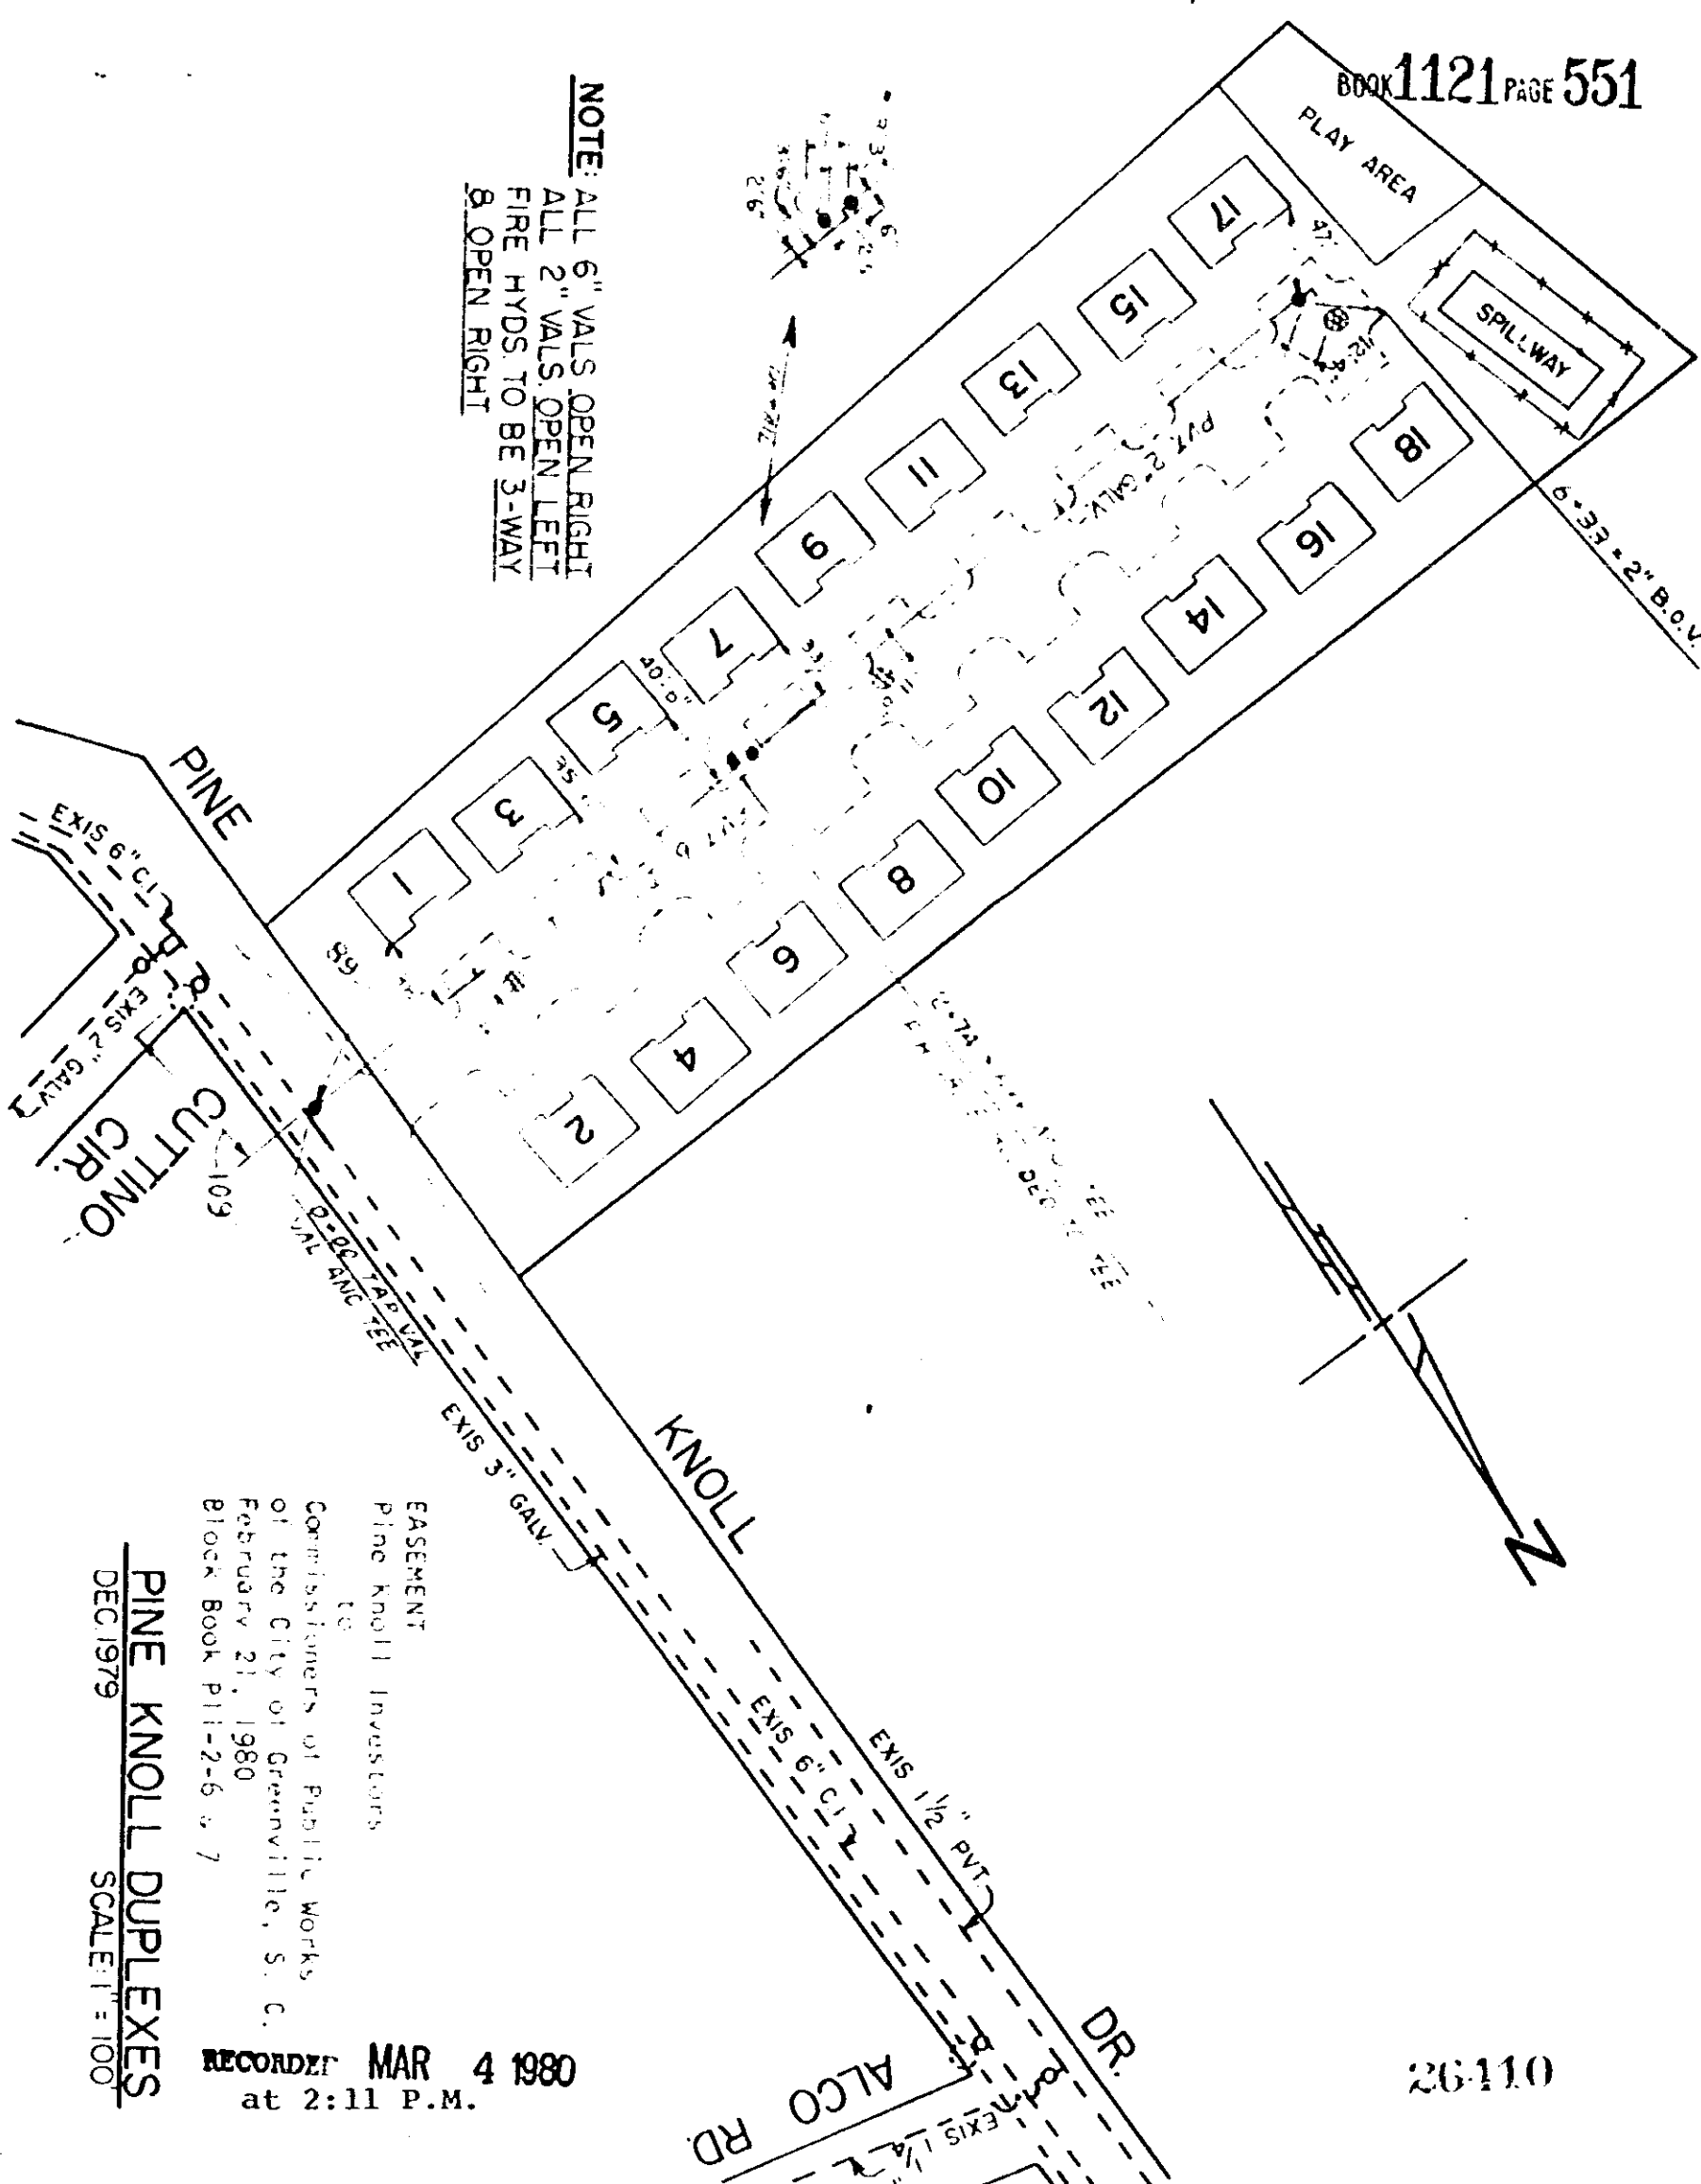

NOTE: ALL 6" VALS. OPEN RIGHT
 ALL 2" VALS. OPEN LEFT
 FIRE HYDS. TO BE 3-WAY
 & OPEN RIGHT

26110

PINE KNOLL DUPLEXES
 DEC 1979 SCALE 1" = 100'

EASEMENT
 Pine Knoll Investors
 to
 Commissioners of Public Works
 of the City of Greenville, S. C.
 February 21, 1980
 Block Book P11-2-6 & 7

RECORDED MAR 4 1980
 at 2:11 P.M.

4328 RV-2