0559

4328 RV-2

BOOK 1121 PAGE 589

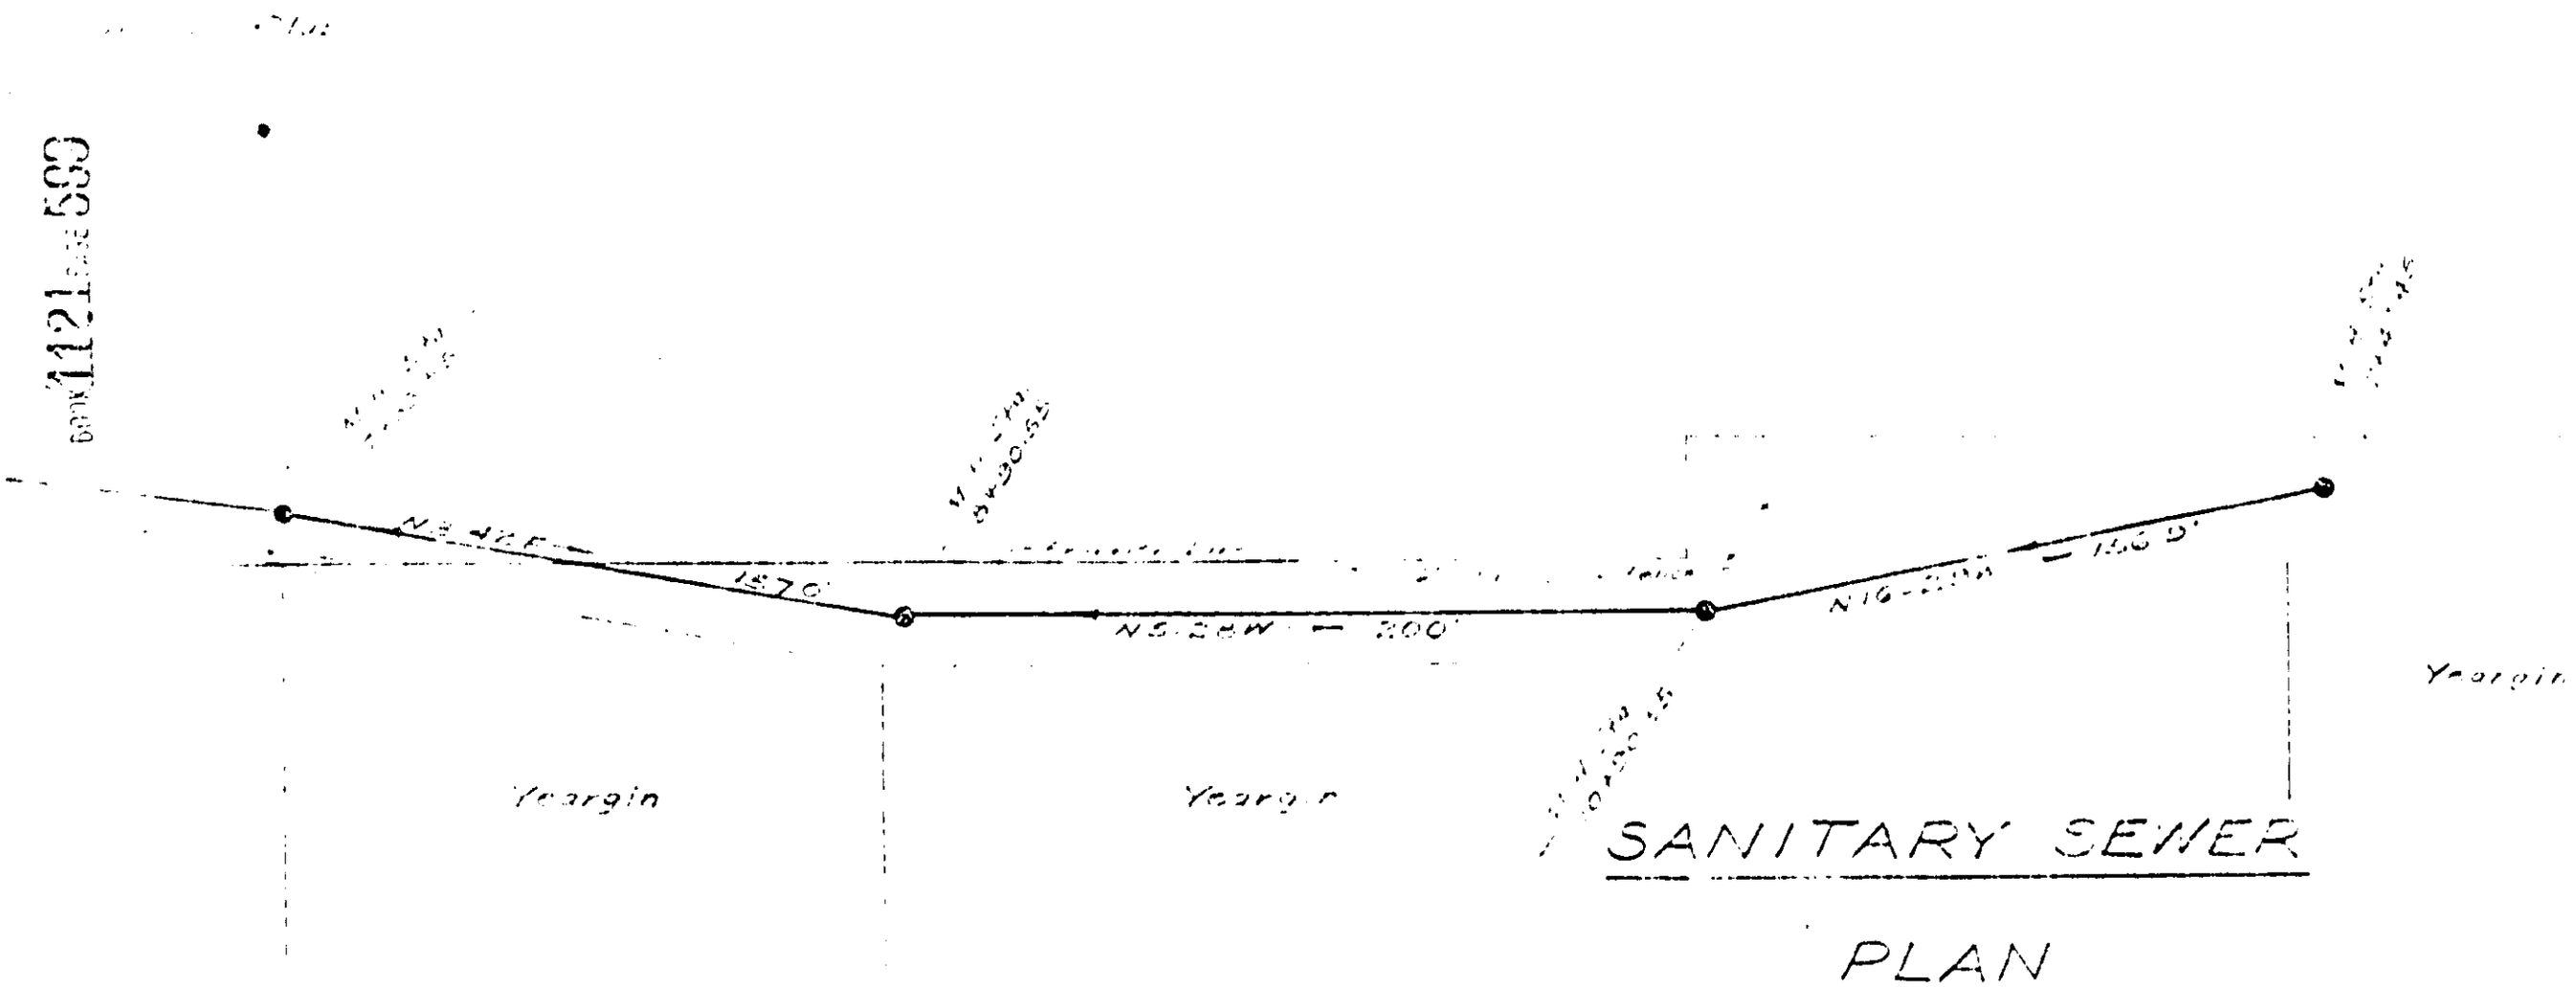

SANITARY SEWER PLAN

SCALE: 1"=50'

YEARGIN PROPERTIES

GREENVILLE, S.C.

REVISED: DEC 4 1978 1) LINE LOCATION MH 0+22± TO MH 1+23±
2) LINE GRADE MH 3+03± TO MH 4+61±