


0150

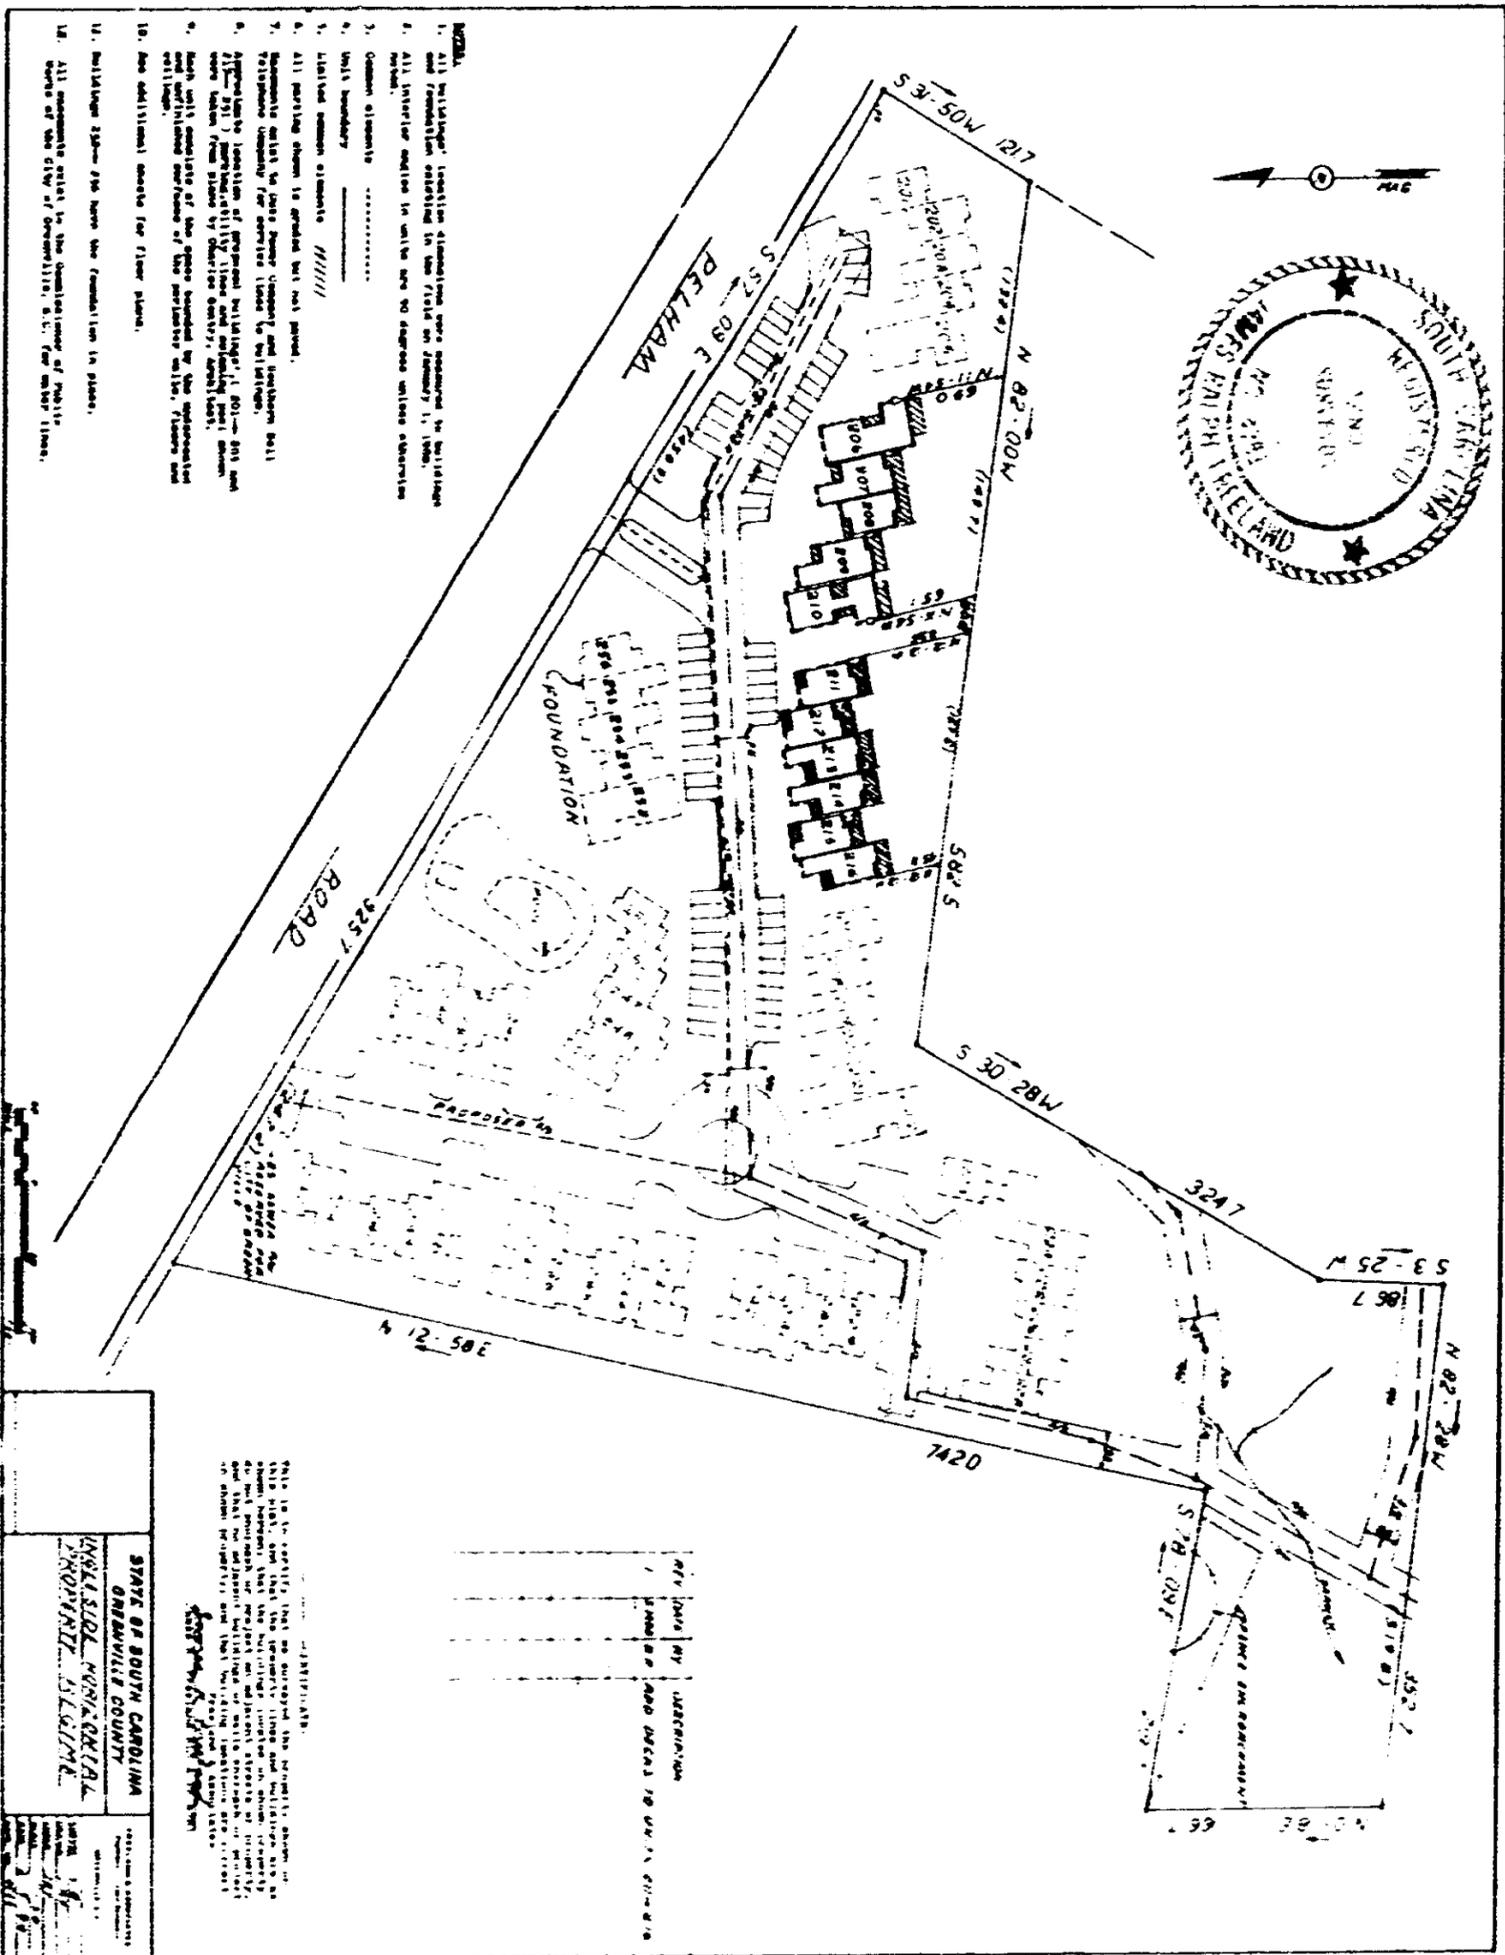

4320 RV-2