
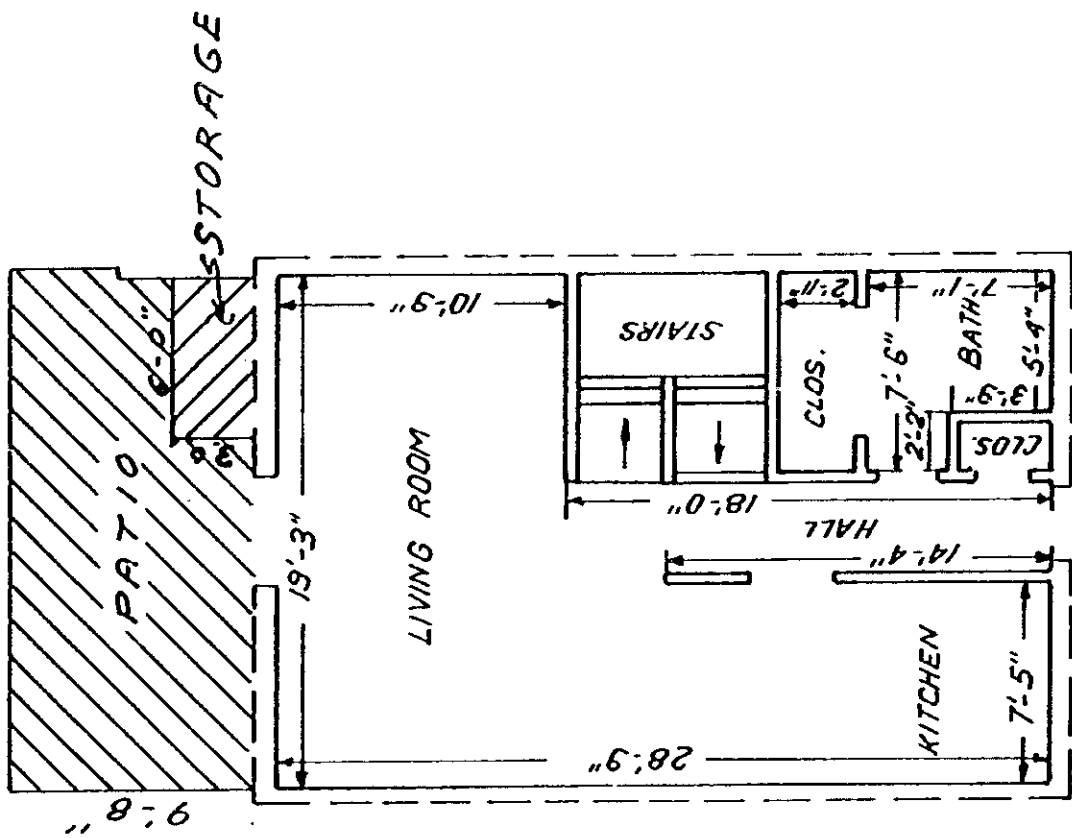


I JAMES R. FREELAND
HEREBY CERTIFY
THAT THE WITHIN
FLOOR PLANS ARE TRUE
AND CORRECT.
SEDFIELD VILLAS
HORIZONTAL PROPERTY
REGIME.
UNIT 24
James R. Freeland

AREA PER RESIDENCE
(SQUARE FEET)
1ST LEVEL 553.44
2ND LEVEL 630.94
TOTAL 1184.38

FREELAND ASSOCIATES
Engineers Land Surveyors
GREENVILLE, S.C.

DATE FEB. 22. 80
SCALE 1/8" = 1'
SHEET 5
DWG. NO. 4755-13

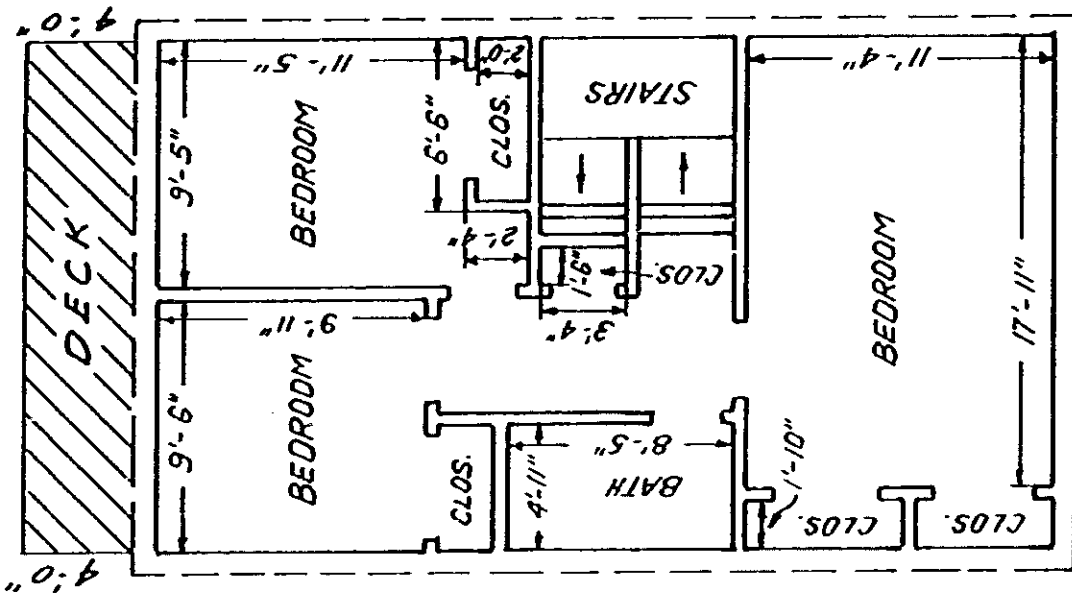

LEGEND
 — UNIT BOUNDARY
 - - - COMMON ELEMENTS
 ▨ LIMITED COMMON ELEMENTS

FLOOR PLAN FOR THREE BEDROOM
SEDFIELD VILLAS
HORIZONTAL PROPERTY REGIME

