



SECOND FLOOR PLAN

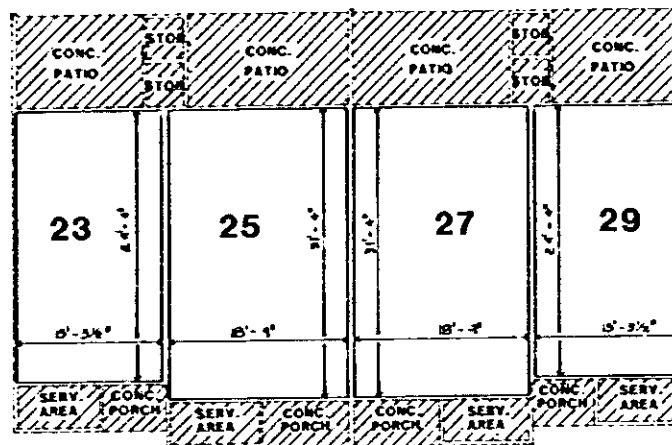

FIRST FLOOR PLAN

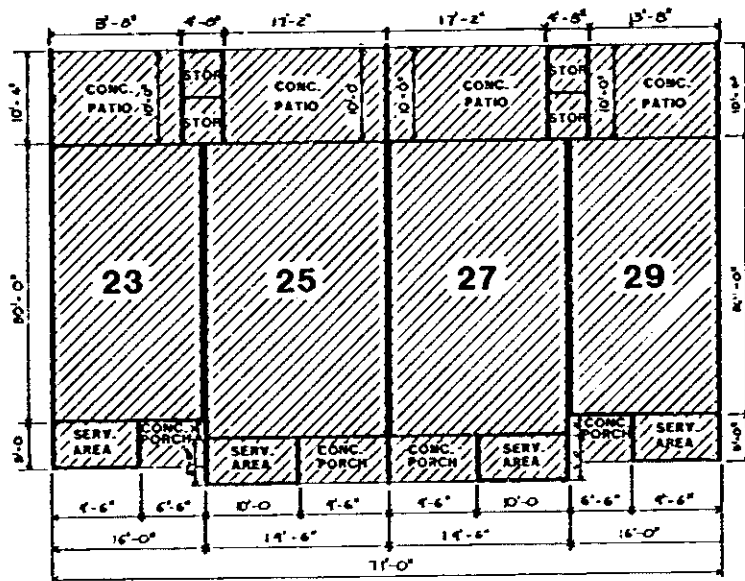

FOUNDATION PLAN

I, ORVILLE V. PLAYER, II, HEREBY CERTIFY THAT THE WITHIN FLOOR PLANS ARE TRUE AND CORRECT TO THE BEST OF MY KNOWLEDGE.

ORVILLE V. PLAYER, II  
S.C. REGISTRATION # 1598

BUILDING 1

LEGEND:

- UNIT BOUNDARY
- GENERAL COMMON ELEMENTS
- LIMITED COMMON ELEMENTS
- "PORCH" DENOTES COVERED AREA
- "PATIO" DENOTES UNCOVERED AREA
- "CONC." DENOTES CONCRETE SLAB-ON-GRADE CONSTRUCTION
- "WOOD" DENOTES ABOVE-GRADE WOODEN CONSTRUCTION



SEDGEFIELD VILLAS  
HORIZONTAL PROPERTY REGIME  
EXHIBIT SHEET

MILLER/PLAYER & ASSOCIATES  
ARCHITECTS AND PLANNERS, LTD.  
James D. Miller, A.L.A. / Orville V. Player, II / Robert C. Cashin



4328 RV-2