


0 3 5 5

FLOOR PLAN - UNIT "B"
0
4
8
16'

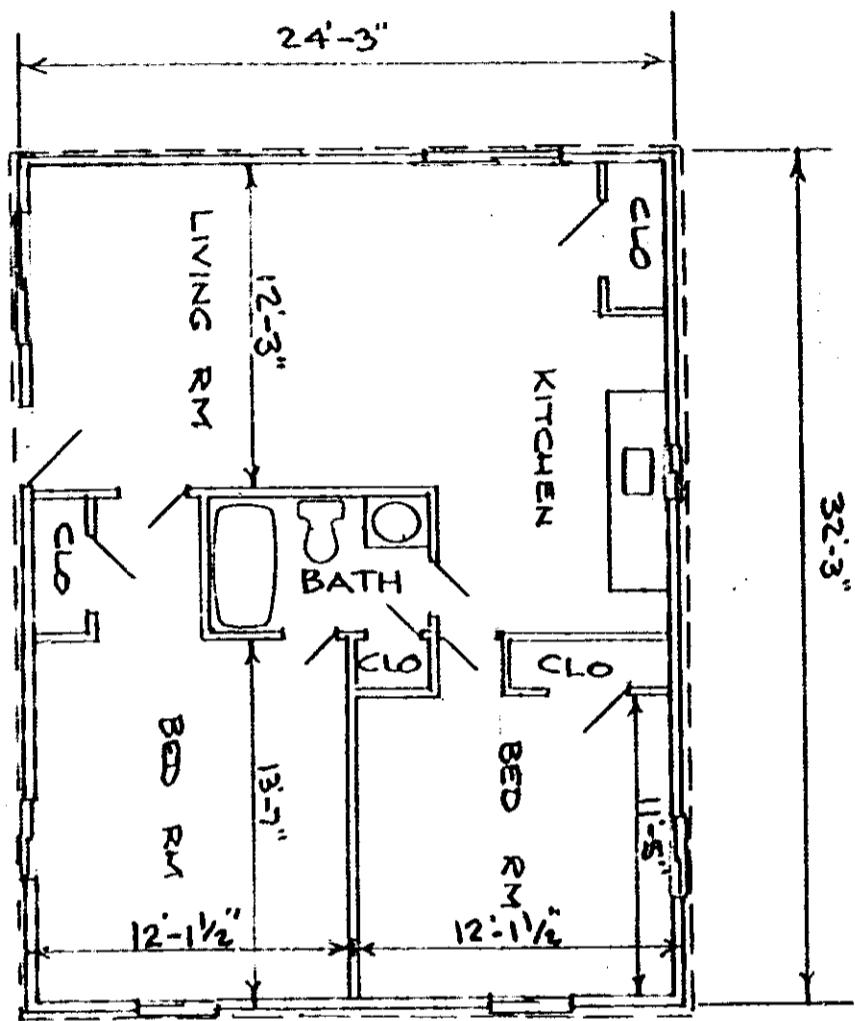

NOTE: FOUNDATION FOR UNIT "B" IS SLAB ON GRADE.

CERTIFICATE

I, Harry H. Payne, do hereby certify that these plans fully depict, within reasonable construction tolerances, the layout, letter identification and dimensions of the buildings and dwellings contained therein.

Harry H. Payne
Oak Grove Village Condominiums
a Horizontal Property Regime
Unit "B"

Units 22-39 as shown on plat.

Legend:

==== common elements



4328 RV-2