BOOK 1135 PAGE 468

AF 10505

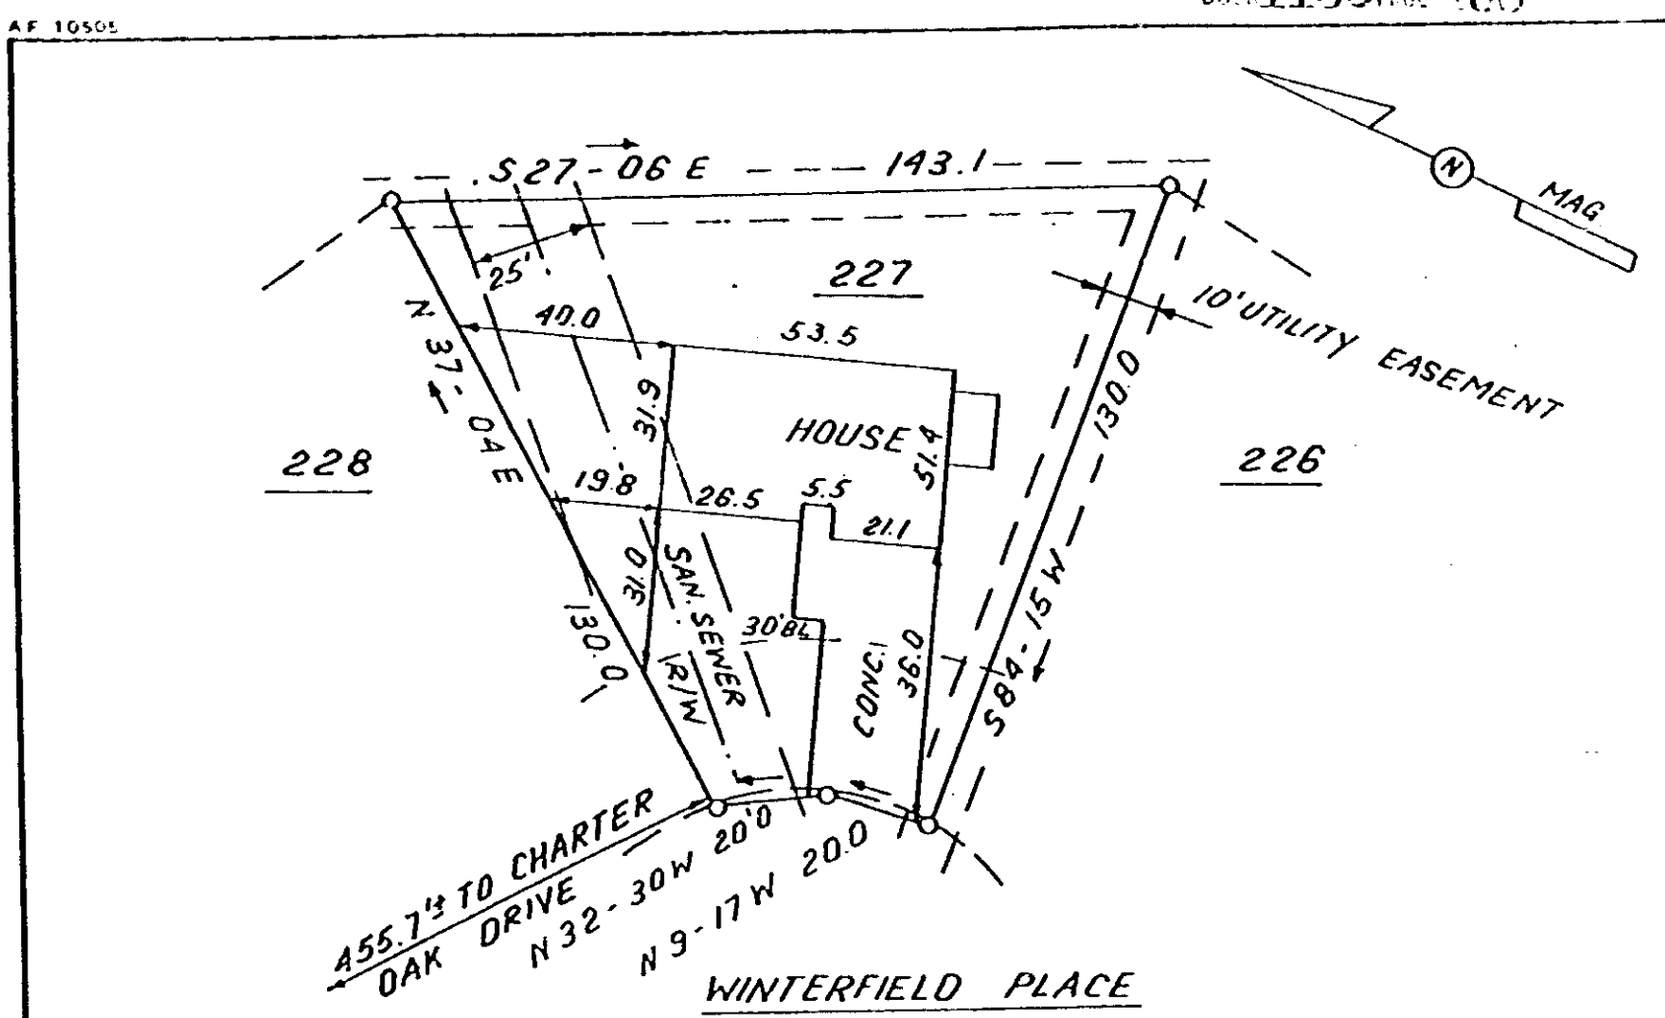

TAX BLOCK BOOK T 27.1-1-69

SOUTH CAROLINA REGISTERED LAND SURVEYOR NO. 4781 JAMES RALPH FREELAND

SEAL

STATE OF SOUTH CAROLINA
GREENVILLE COUNTY

PEPPERTREE
LOT 227, SECT. 2
PROPERTY OF
WILLIAM HARRY HOWARD

FREELAND & ASSOCIATES
GREENVILLE S.C.

SURVEY D.C.H.
DRAWN B.R.
CHECK MC
SCALE 1" = 40
DATE AUG 8 80
DWG NO 5419

RECORDED OCT 14 1980 at 12:24 P.M. 11666

4328 RV.2