

Name and Post Office Address of Grantor DANNY BARNES
2361 N. PLEASANTBURG DR.
GREENVILLE, S.C., 29609

Toll Line or Exchange Line GREENVILLE, SOUTH CAROLINA
tributary to _____

The Property is bounded where the line enters and leaves this property by the property of:

SUMTER STREET on the SOUTH
and REEDY RIVER on the NORTH

Authority C-6985 Classification R45C

Area GREENVILLE, SOUTH CAROLINA


Approved _____

Title _____

13082 *
OCT 27 1980

Filed for recording in office of
the R. M. C. for Greenville
County, S. C. at 11:12 o'clock
A.M. Oct. 27, 1980
and recorded in Deed Book
1136 at page 239

R. M. C. for G. Co. S. C.

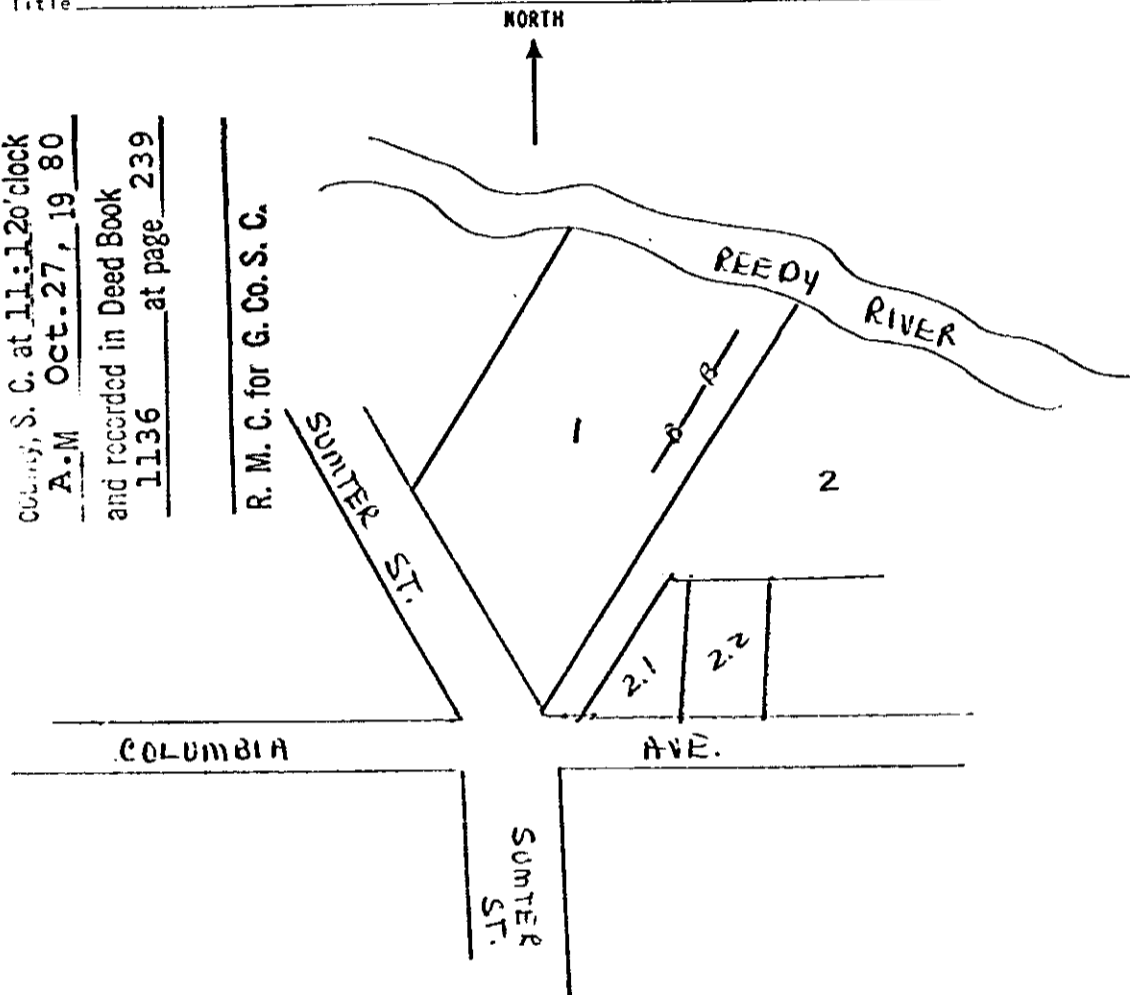

RECORDED OCT 27 1980

at 11:12 A.M.

13082

0 2 4 9

4328 RV-2