


1/20/50

ROAD (E-273)

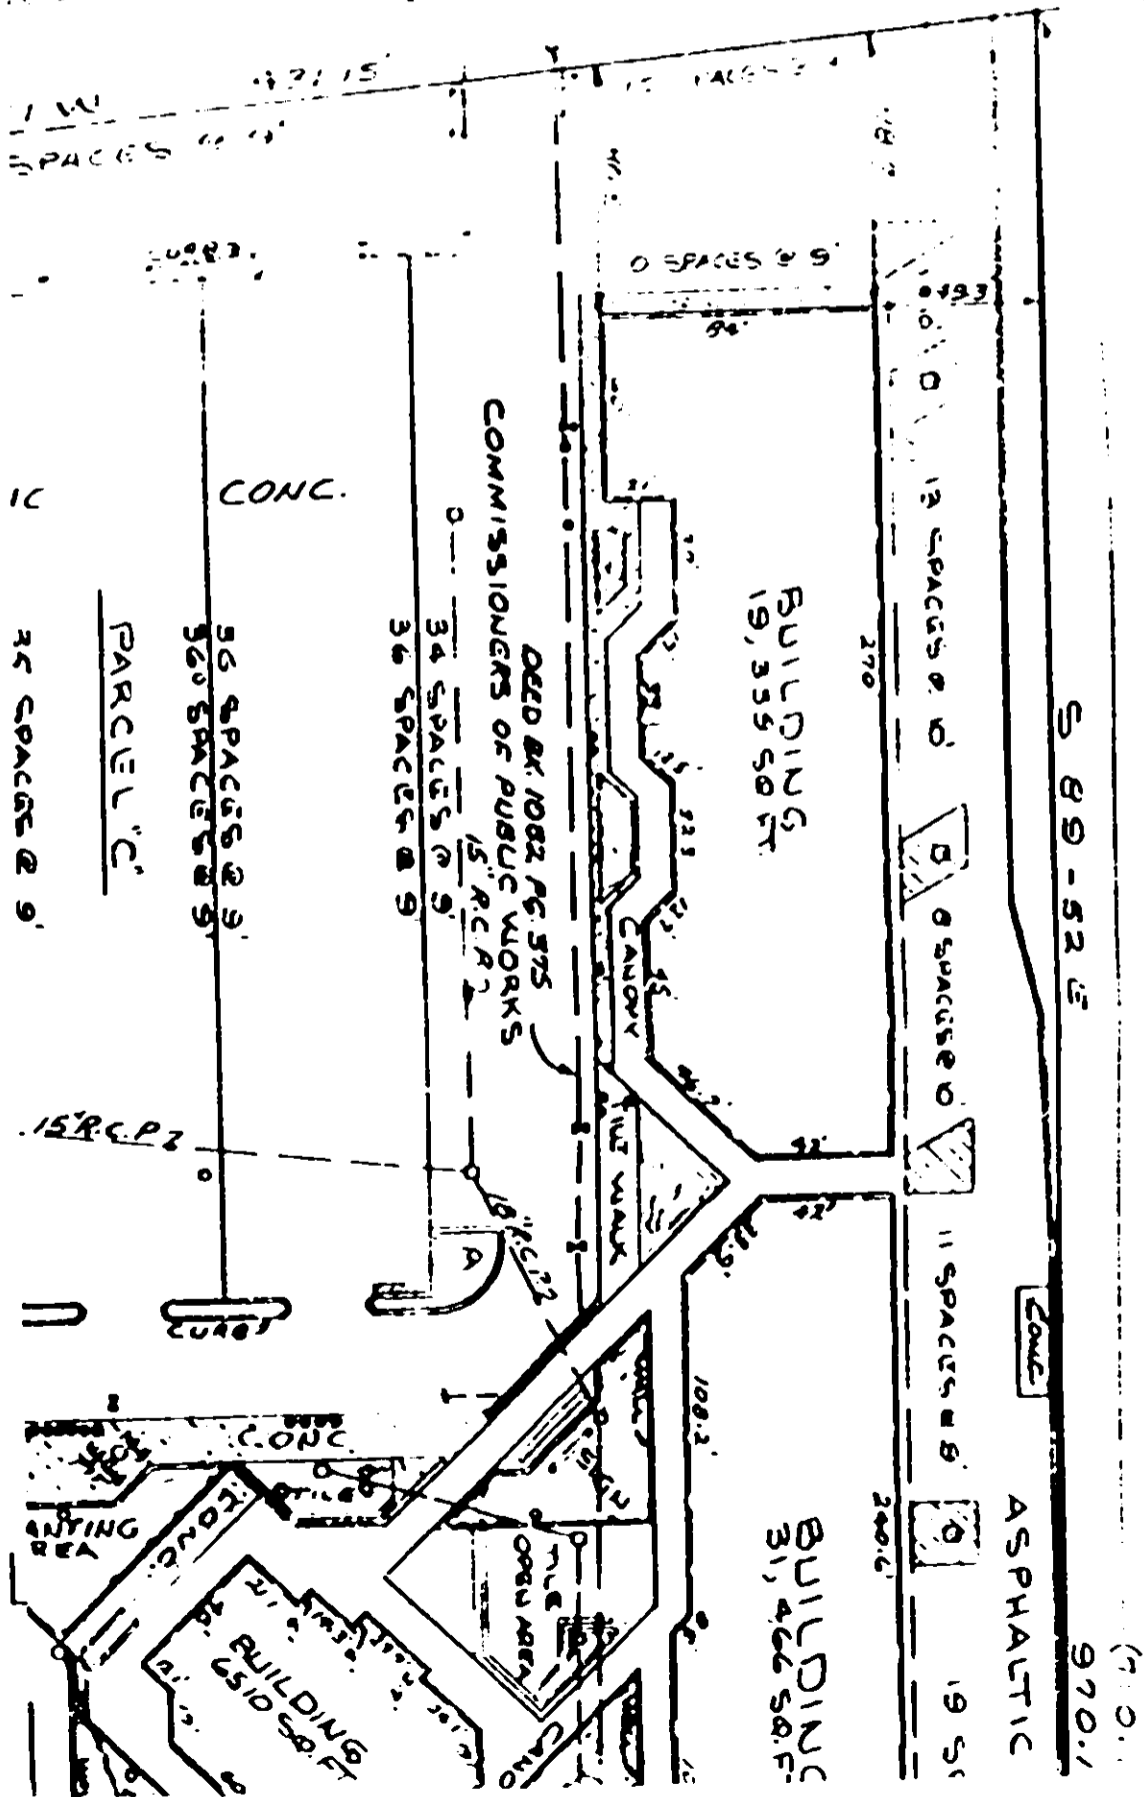

-T.C. VAUGHAN-