

1146 990

Name and Post Office Address of Grantor: South Forest Estates, Inc.
P.O. Box 87
Greenville, South Carolina 29602


City or Exchange Line: Greenville, South Carolina

The Property is bounded where the line appears and issues this property to the property of:
Stratford South
McQueen Eunice Brock West

City, P-43308 Greenville, South Carolina Block or Lot R45C

Prepared by: J. J. Jaffe
Dist. Clerk Dist.

NORTH

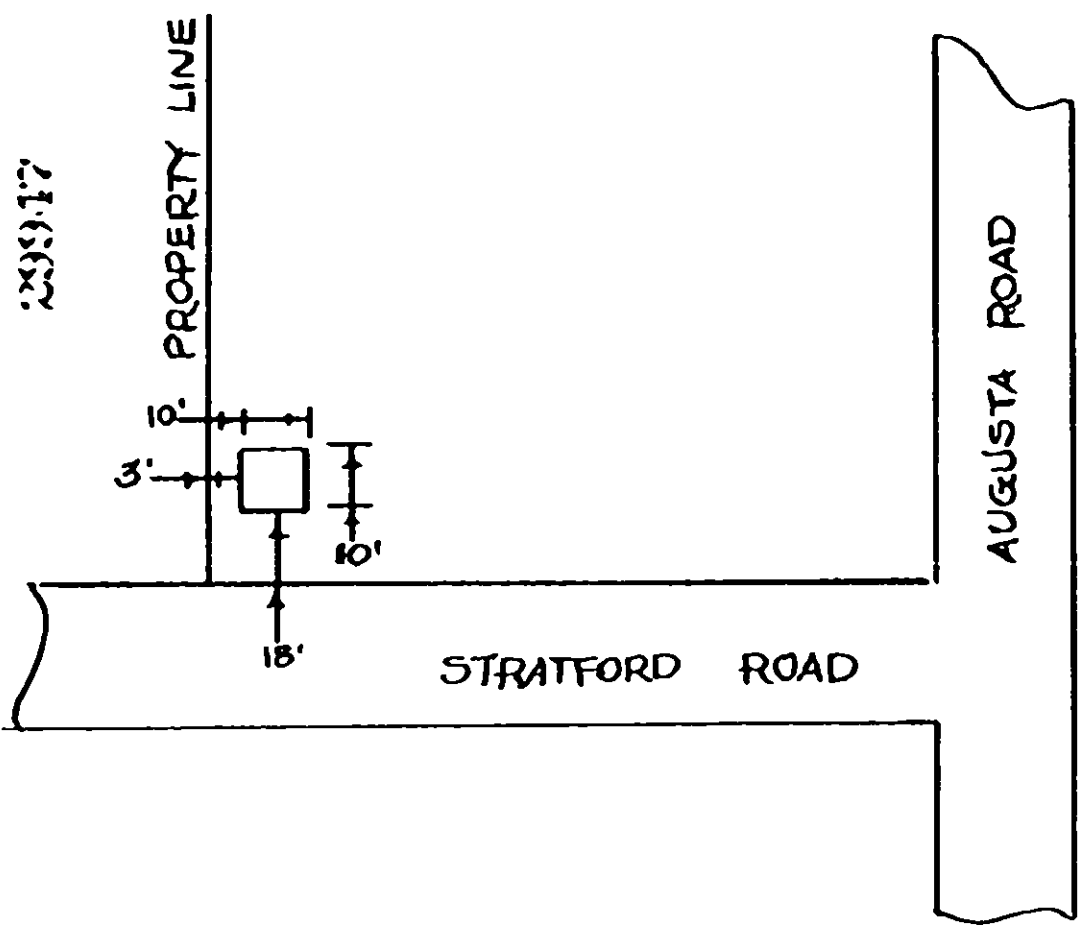

APR 27 1981

259317

Filed for record in the office of
 the R. M. C. for Greenville
 county, S. C. at 10:46 a'clock
A.M. APR. 27, 19 81
 and recorded in Deed Book
1146 at page 989

R. M. C. for G. Co. S. C.

RECORDED APR 27 1981 at 10:46 A.M.

259317-4x

0999

4328 RV-2