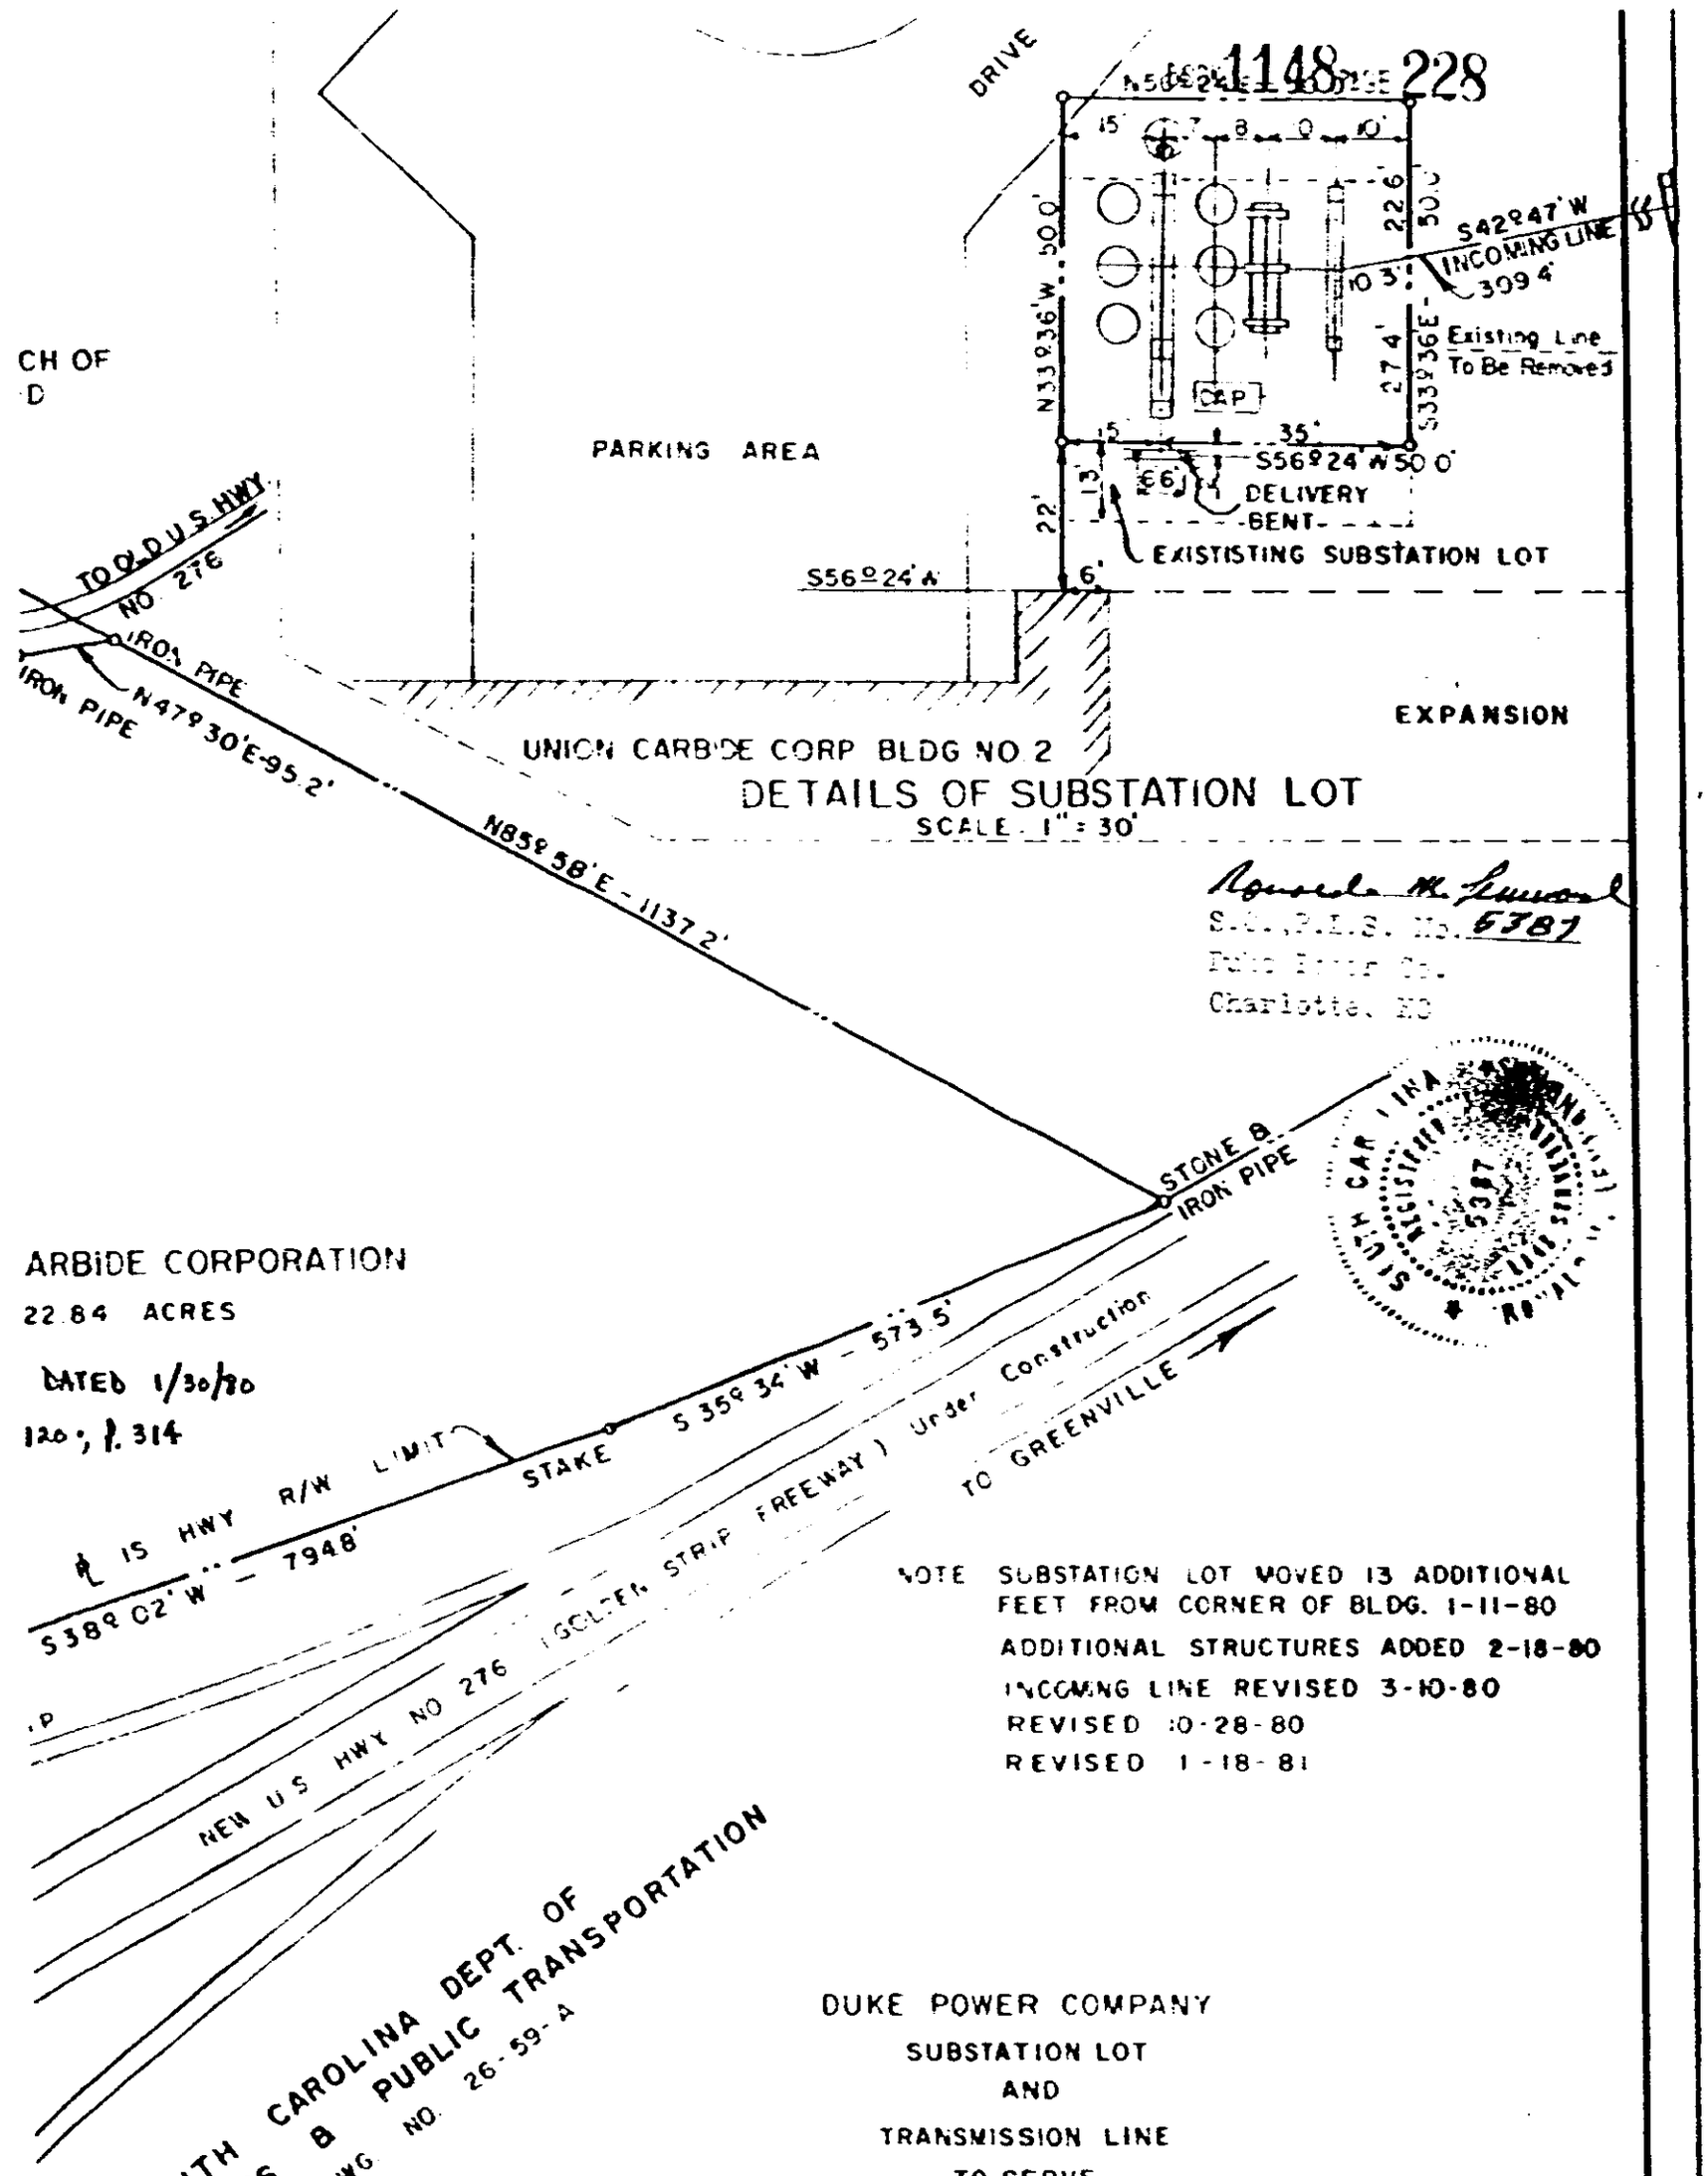

Roscoe M. Lawson
Duke Power Co.
Charlotte, NC

NOTE SUBSTATION LOT MOVED 13 ADDITIONAL FEET FROM CORNER OF BLDG. 1-11-80
ADDITIONAL STRUCTURES ADDED 2-18-80
INCOMING LINE REVISED 3-10-80
REVISED 10-28-80
REVISED 1-18-81

DETAILS OF SUBSTATION LOT

SCALE 1" = 30'

DUKE POWER COMPANY
SUBSTATION LOT
AND
TRANSMISSION LINE
TO SERVE
UNION CARBIDE CORPORATION
MAULDIN, S.C.
GREENVILLE COUNTY

32033

RECORDED MAY 18 1981
at 10:50 A.M.

T.O. NO. 7690-1

SCALE 1" = 200'
BOOK NO 641 & 1626

JUNE 11, 1964
FILE NO 155-08

0228
4326 RV.2