


**EXHIBIT A**

BOOK 1149 PAGE 687



...SECOND FLICK HAN

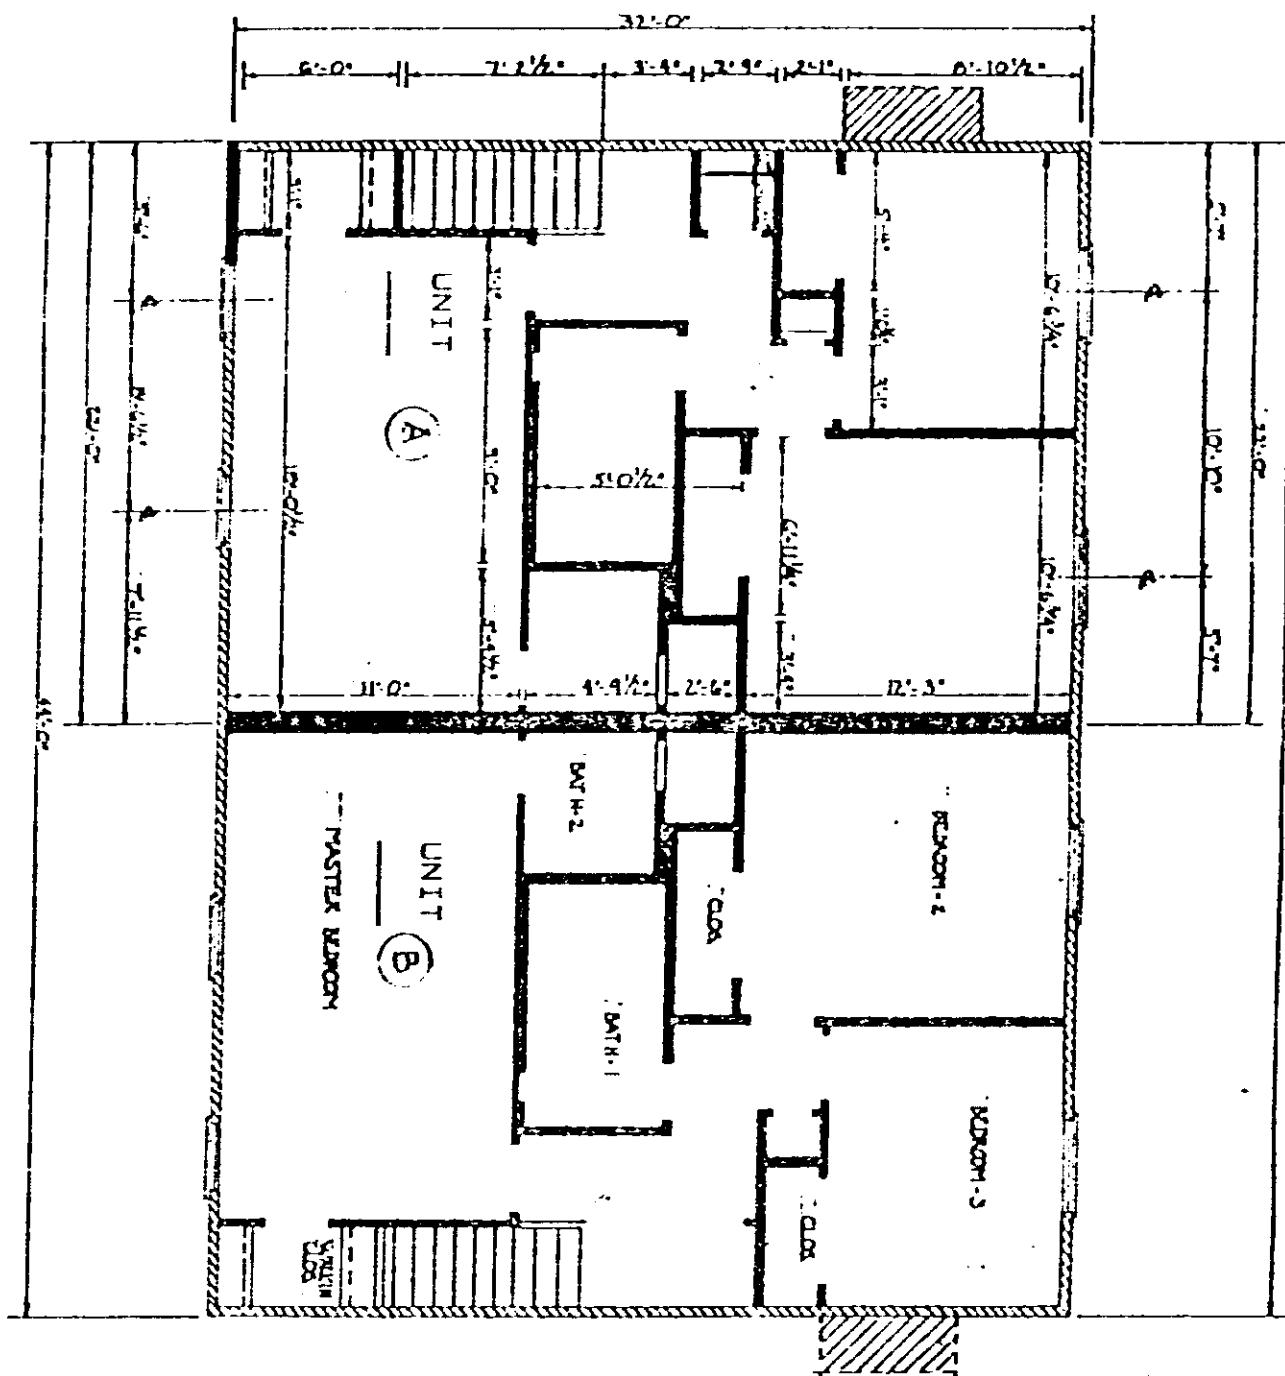

**CERTIFICATE**

I, Wade H. Barber, do hereby certify that these plans fully depict within reasonable construction tolerances the layout, location, letter identification and dimensions of the buildings and dwellings contained therein.

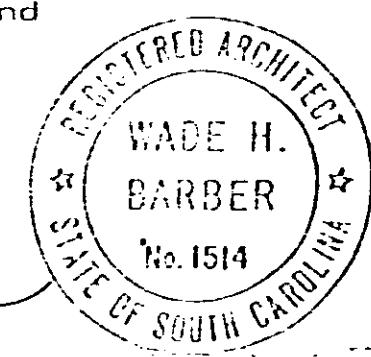

Wade F. Barber

4328 RV-2