REGISTERED ARCHITECT
WADE H. BARBER
No. 1514
STATE OF SOUTH CAROLINA

CERTIFICATE

I, Wade H. Barber, do hereby certify that these plans fully depict within reasonable construction tolerances the layout, location, letter identification and dimensions of the buildings and dwellings contained therein.

Wade H. Barber

3. WINDOW HEAD @ FIRST FL. TO BE [illegible]
@ SECOND FL. [illegible]
4. DECK SIZE & SHAPE & FOUNDATION DETERMINED [illegible] BY OWNER.
INSTALL 42" HIGH HANDRAIL @ DECKS & STAIRS AS SPECIFIED BY OWNER & REQD BY CODE.
DECK SIZE 160 SF MIN.; STOOP LANDING [illegible]

LIMITED COMMON ELEMENTS

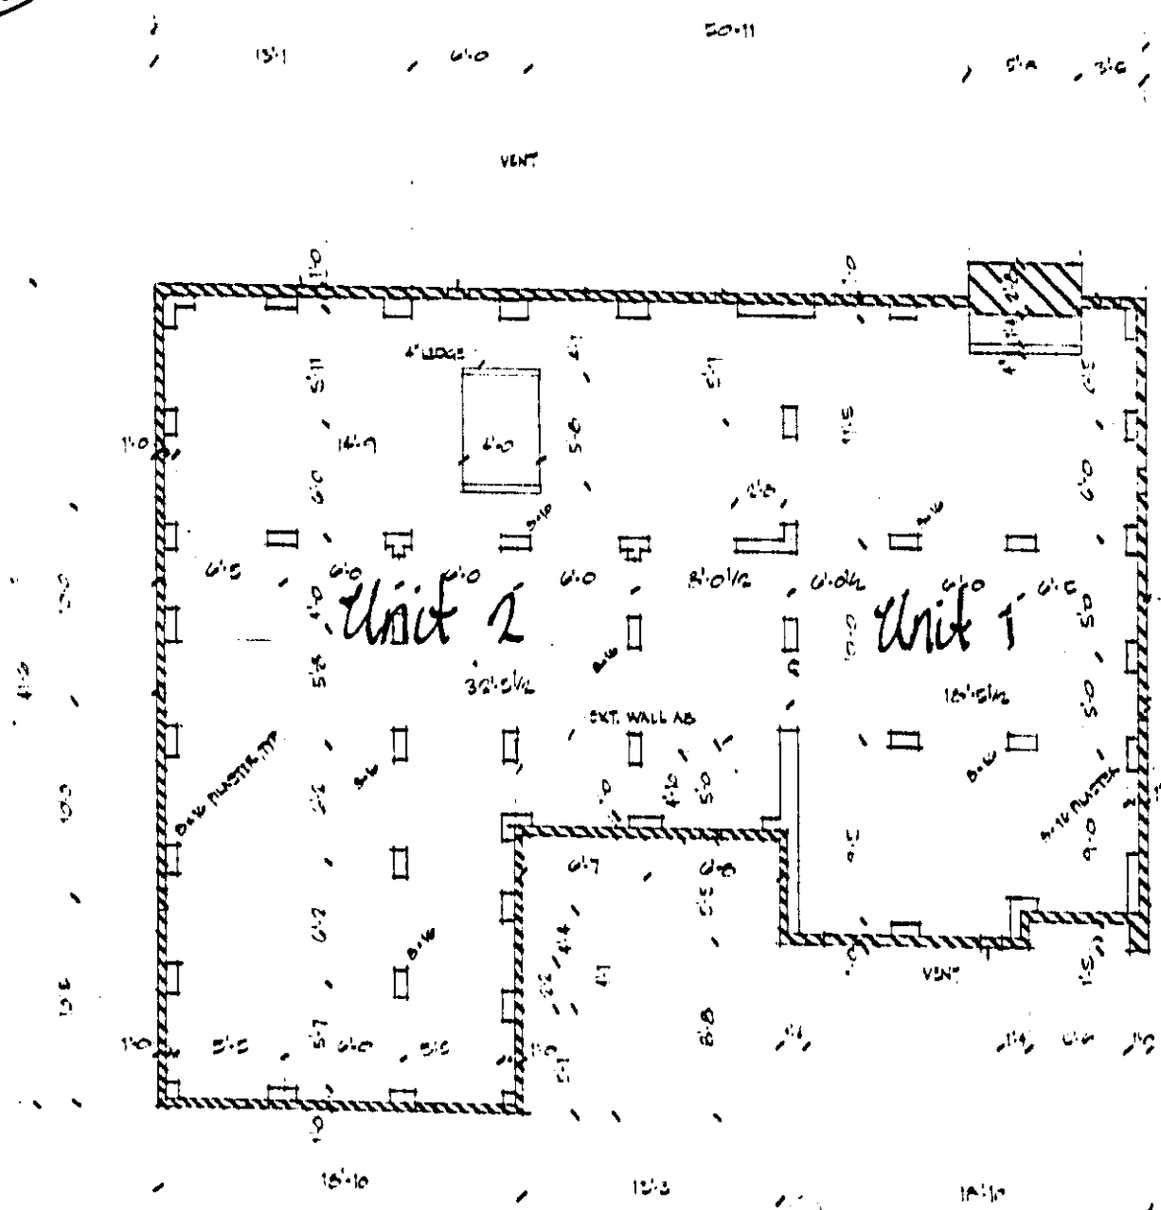

FOUNDATION
SEE NOTE 3 SHT 5

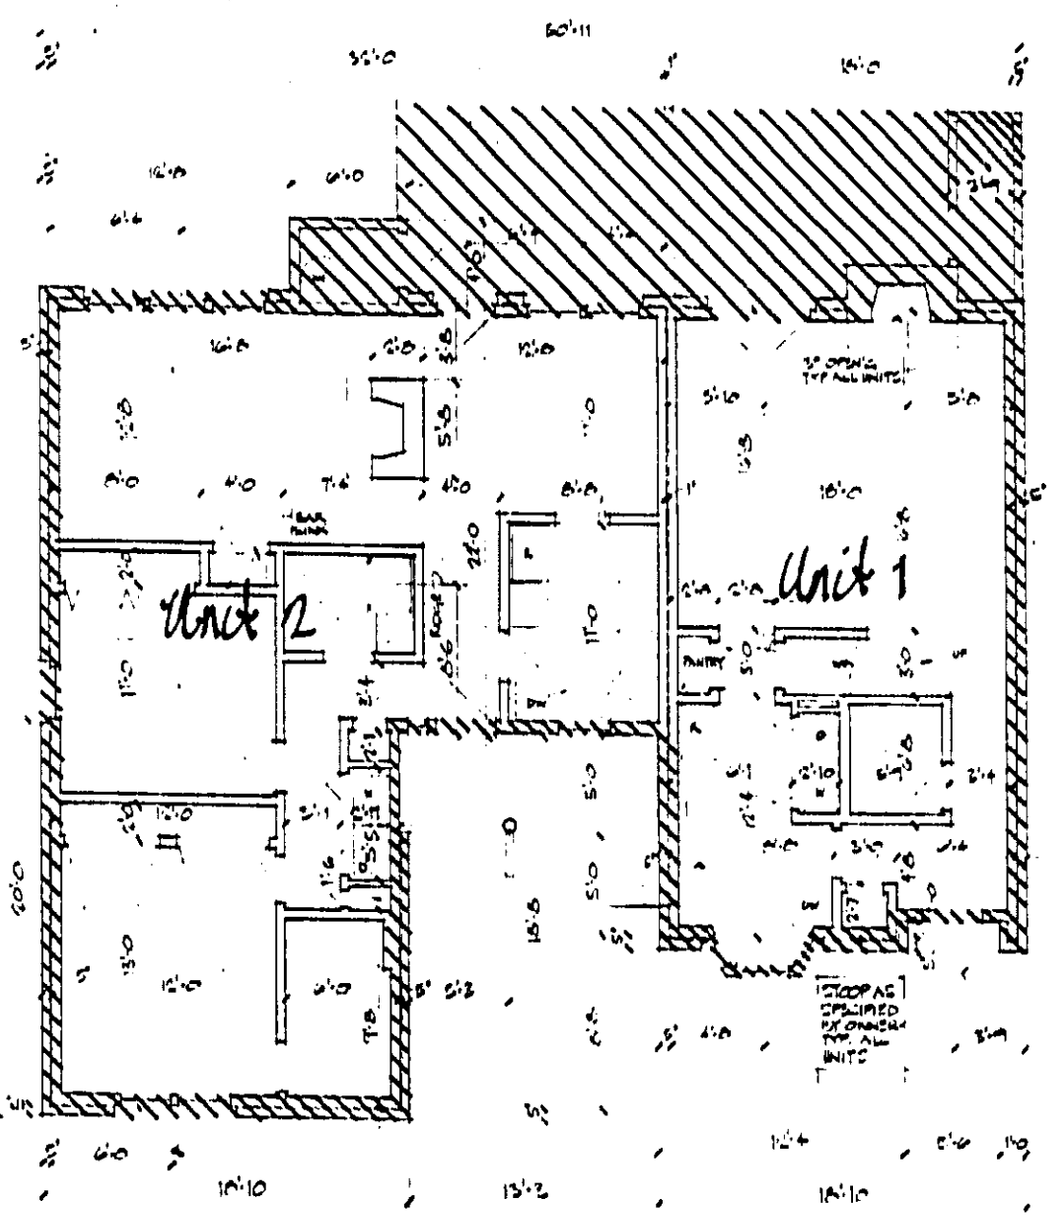

FIRST FLOOR
SEE SHT 12 FOR [illegible] PLAN OF GER UNIT REVERSED

0 5 10 20

PLANS - BLDG A
BRICK VENEER

4328 RV-2

0076