LIMITED COMMON ELEMENTS

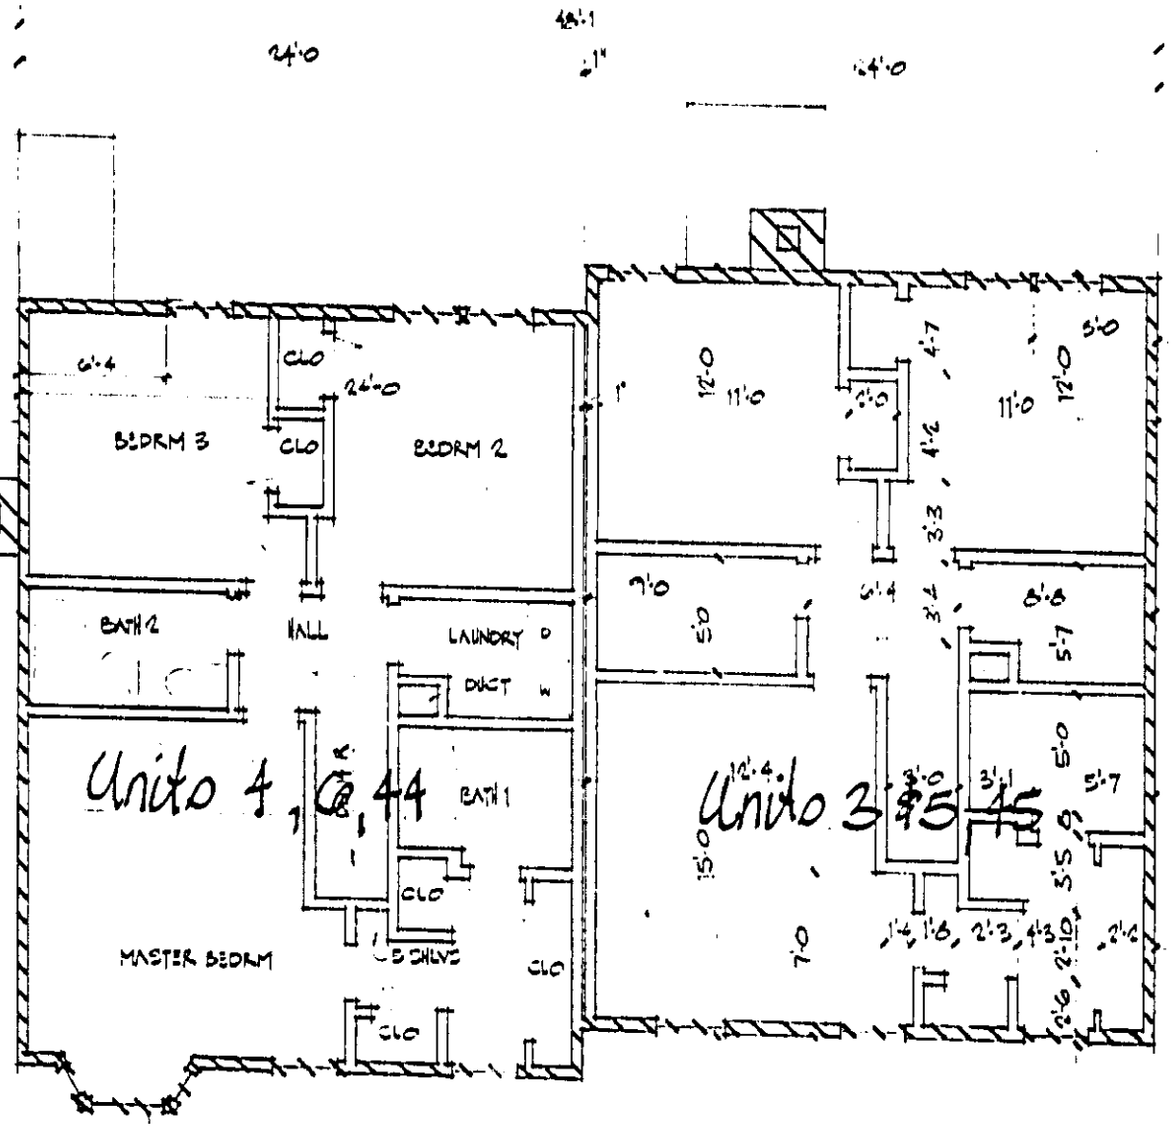

SECOND FLOOR
WINDOW HEADS @ 7'-0 AFF. TYP. OF 2ND FL

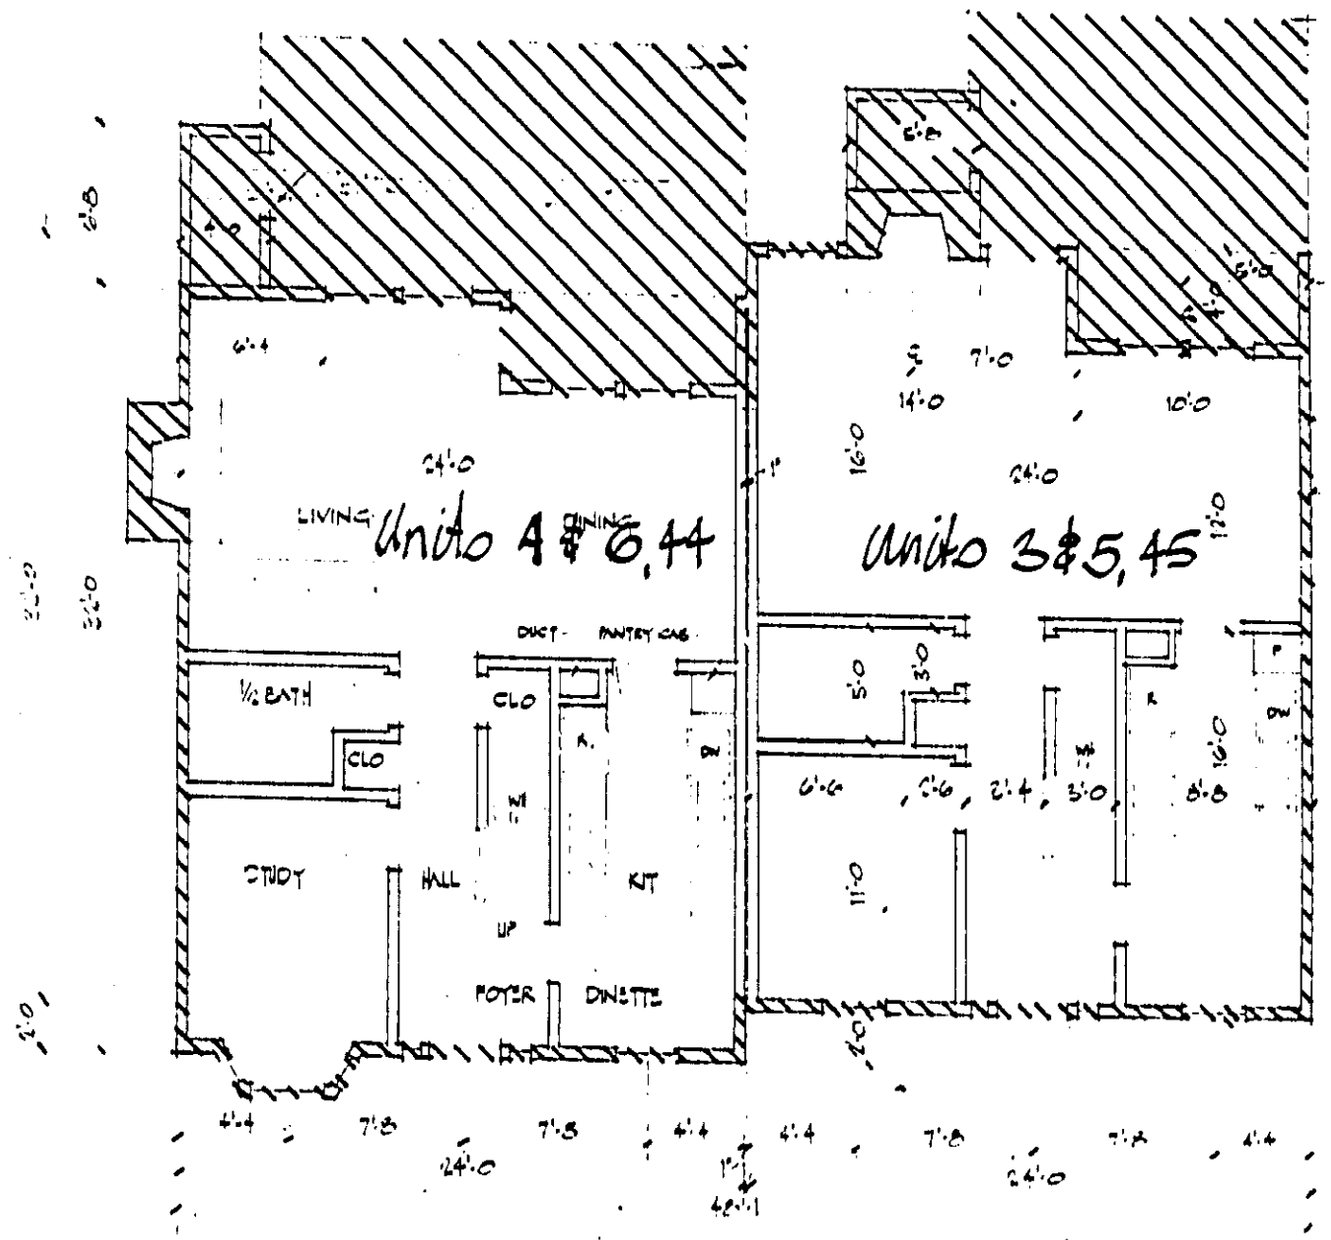

FIRST FLOOR
WINDOW HEADS @ 6'-8" AFF

REGISTERED ARCHITECT
WADE H. BARBER
No 514
STATE OF SOUTH CAROLINA

CERTIFICATE

I, Wade H. Barber, do hereby certify that these plans fully depict within reasonable construction tolerances the layout, location, letter identification and dimensions of the buildings and dwellings contained therein. Wade H. Barber

PLAN - BLDG B

4328 RV-2

0078