


Name and Post Office Address of Grantor: **Mr. Wallace E. Turner**
P. O. Box 4301
Greenville, South Carolina 29608

Toll Line or Exchange Line tributary to: **S #102 Batson Drive**
Greenville, South Carolina

The Property is bounded where the line enters and leaves this property by the property of:
Lloyd Bostian on the **West**

Authority: **P-43387** Classification: _____
 Area: **South Carolina**

Approved: _____
 Title: **District Manager - Distribution**

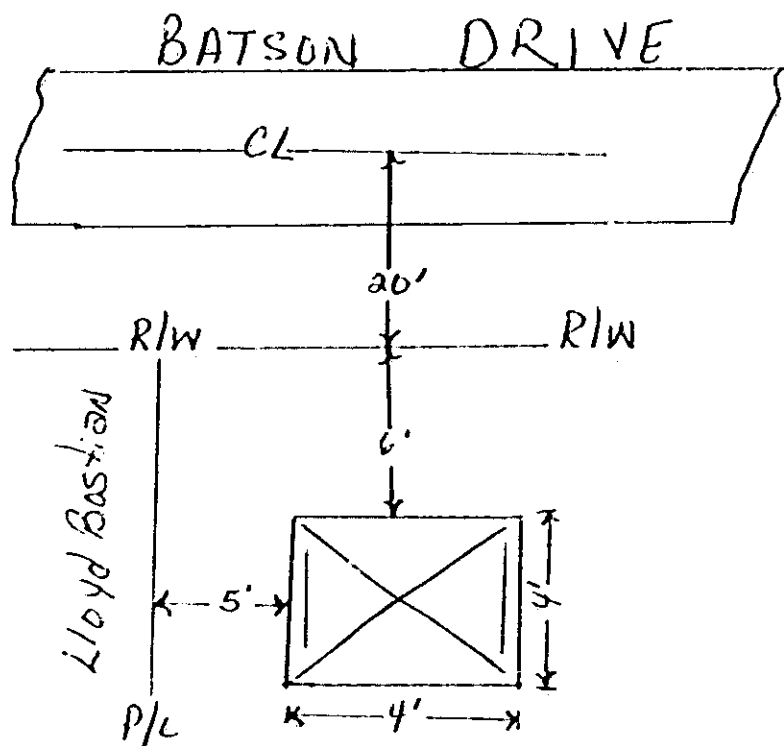

Recorded July 28, 1981 at 3:38 P/M # 2453

Filed for record in the office of
 the R. M. C. for Greenville
 County, S. C. at 3:38 P.M. July 28, 1981
 and recorded in Deed Book 523
 1152 at page _____
 R. M. C. for G. Co. S. C.

JUL 28 1981
 2453

4328 RV-2

0524