



SECOND FLOOR PLAN

**LEGEND:**

- UNIT BOUNDARY
- - - GENERAL COMMON ELEMENTS
- ▨ LIMITED COMMON ELEMENTS
- "PORCH" DENOTES COVERED AREA
- "PATIO" DENOTES UNCOVERED AREA
- "CONC." DENOTES CONCRETE SLAB-ON-GRADE CONSTRUCTION
- "WOOD" DENOTES ABOVE-GRADE WOODEN CONSTRUCTION

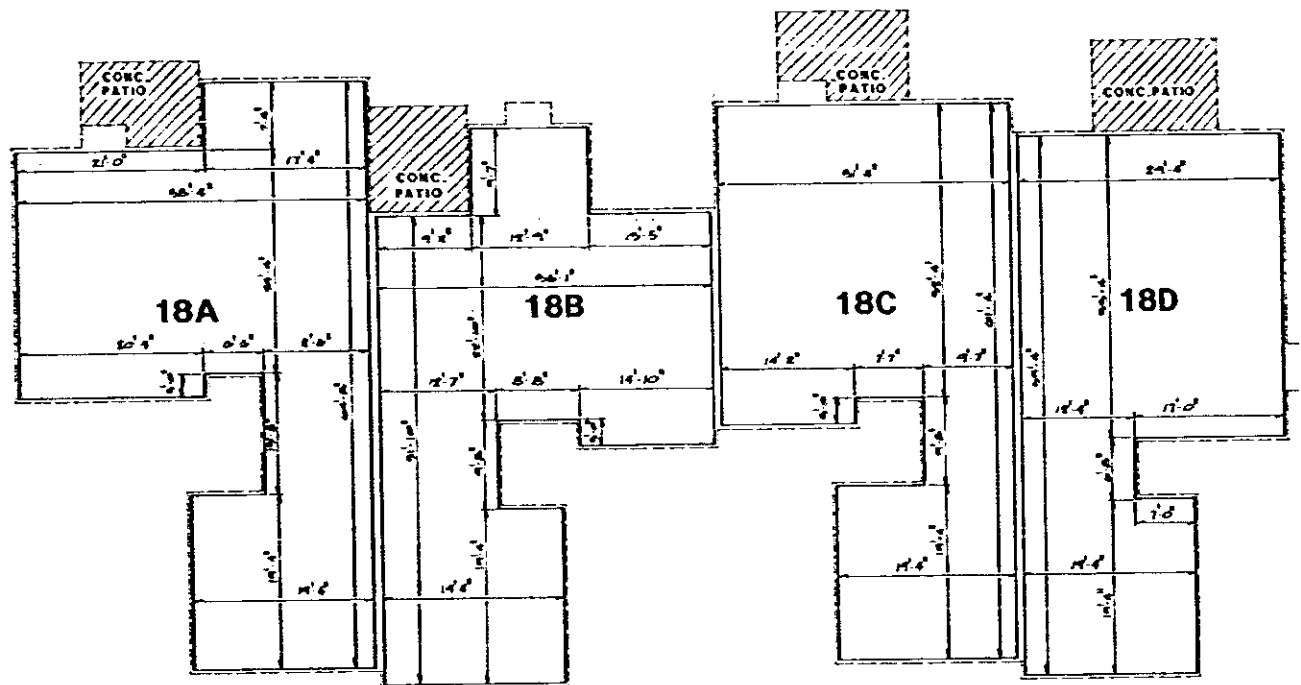

FIRST FLOOR PLAN

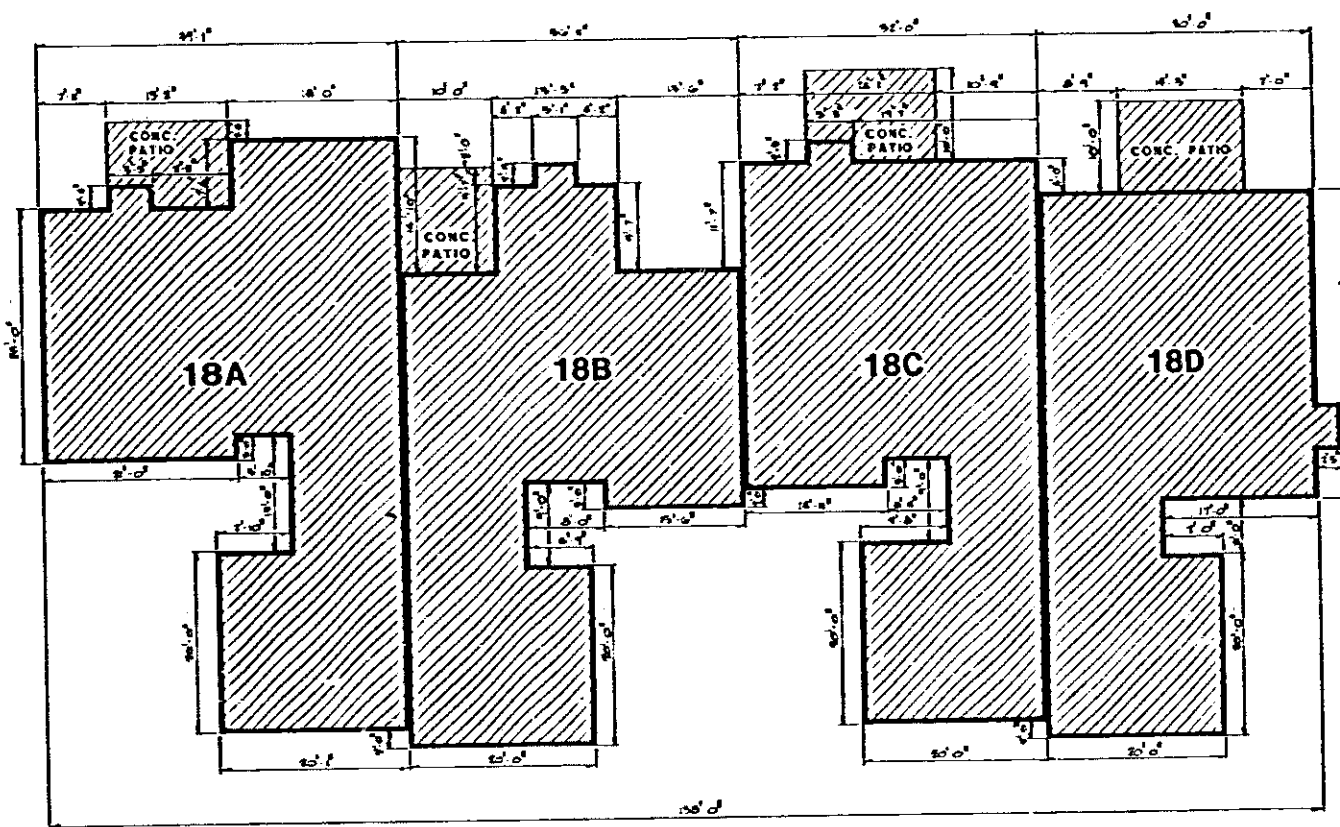

I, ORVILLE V. PLAYER III, HEREBY CERTIFY THAT THE WITHIN FLOOR PLANS ARE TRUE AND CORRECT TO THE BEST OF MY KNOWLEDGE.

*Orville V. Player III*  
ORVILLE V. PLAYER III  
SC. REGISTRATION # 1596

FOUNDATION PLAN

BUILDING 18



SUGAR CREEK VILLAS  
HORIZONTAL PROPERTY REGIME

EXHIBIT B SHEET 2

**MILLER/PLAYER & ASSOCIATES**  
ARCHITECTS AND PLANNERS, LTD.

James D. Miller, A.I.A. / Orville V. Player, III / Robert C. Cashner