

Name and Post Office Address of Grantor: Henry D. Burns
P. O. Box 205
Travelers Rest, SC

Toll Line or Exchange Line tributary to: Travelers Rest Exchange - Marietta Office

The Property is bounded where the line enters and leaves this property by the property of: Chinqupin Road on the East

and _____ on the _____


Authority: P-43397 Classification: R45-C

Area: Greenville District

Approved _____

Title: District Manager - Distribution

NORTH

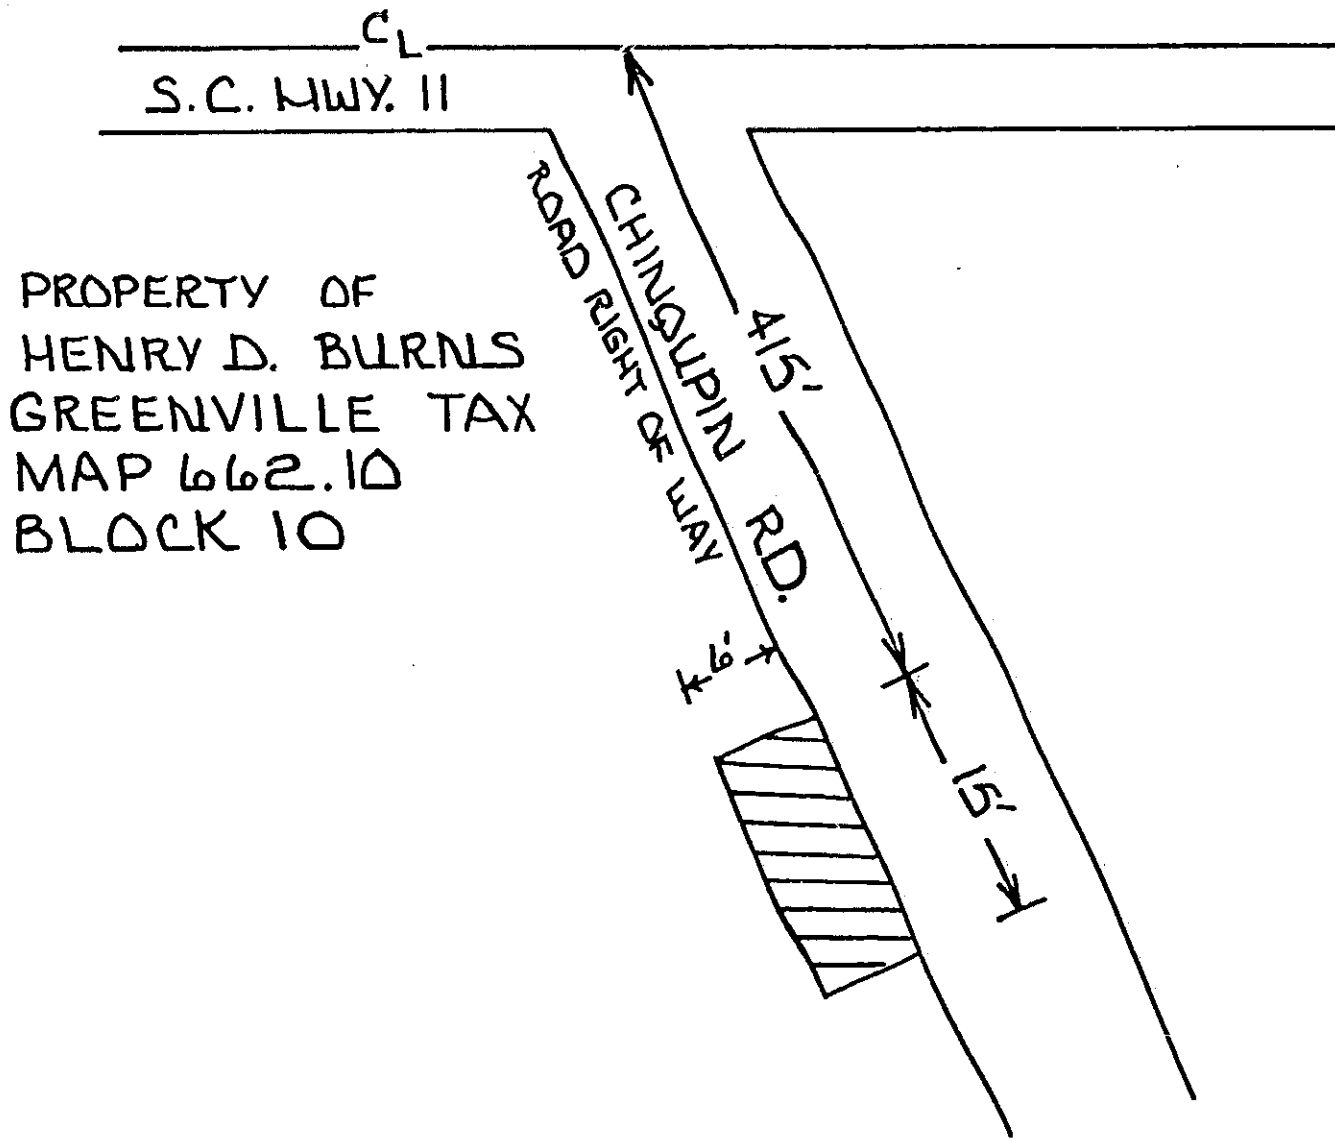

PROPERTY OF
 HENRY D. BURNS
 GREENVILLE TAX
 MAP 662.10
 BLOCK 10

RECORDED OCT 9 1981 at 10:25 A.M.

9007

Filed for record in the office of
 the R. M. C. for Greenville
 County, S. C. at 10:25 o'clock
 A.M. Oct. 9, 19 81
 and recorded in Deed Book
 1156 at page 582
 R. M. C. for G. Co. S. C.

OCT 9 1981

9007

*mail all
envelopes*

4328 RV-2

058