


RAINBOW VILLAS PROPERTY REGIME
TYPICAL BUILDING ELEVATION FROM SIDE
(BUILDING "A" & "B")

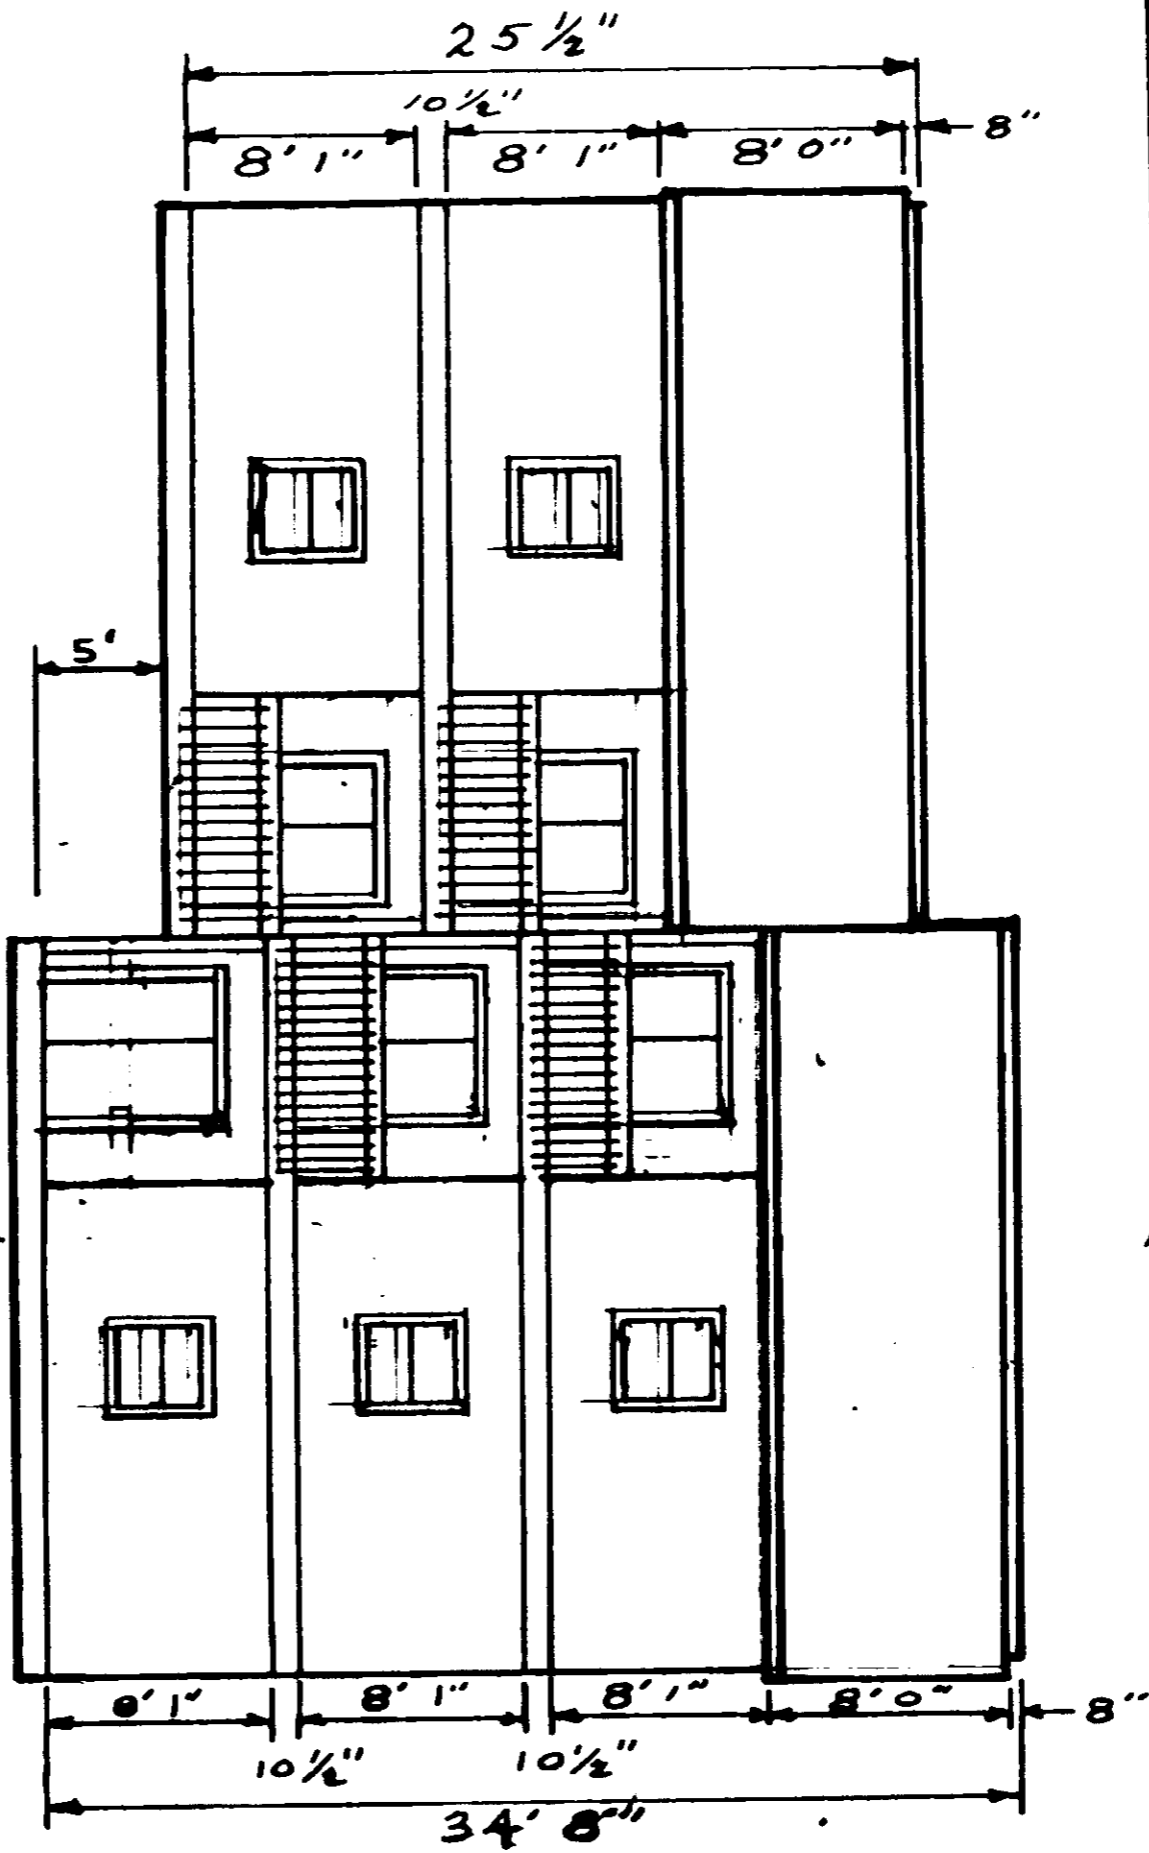

I, JAMES S. MCKINNEY, HEREBY CERTIFY THAT THE WITHIN FLOOR PLANS ARE TRUE AND CORRECT TO THE BEST OF MY KNOWLEDGE.

James S. McKinney
JAMES S. MCKINNEY
S. C. REG. NO. 3088

0947

4328 RV.2