

Name and Post Office Address of Grantor James H. Thompson  
Route 2  
Taylors, SC 29687


File No. \_\_\_\_\_

Toll Line or Exchange Line tributary to Blue Ridge (Name)  
 (Exchange)

The Property is bounded where the line enters and leaves this property by the property of:  
 \_\_\_\_\_ on the \_\_\_\_\_  
 and \_\_\_\_\_ on the \_\_\_\_\_

Authority P-43429 Classification R45C  
 Area South Carolina

Approved \_\_\_\_\_  
 Title \_\_\_\_\_

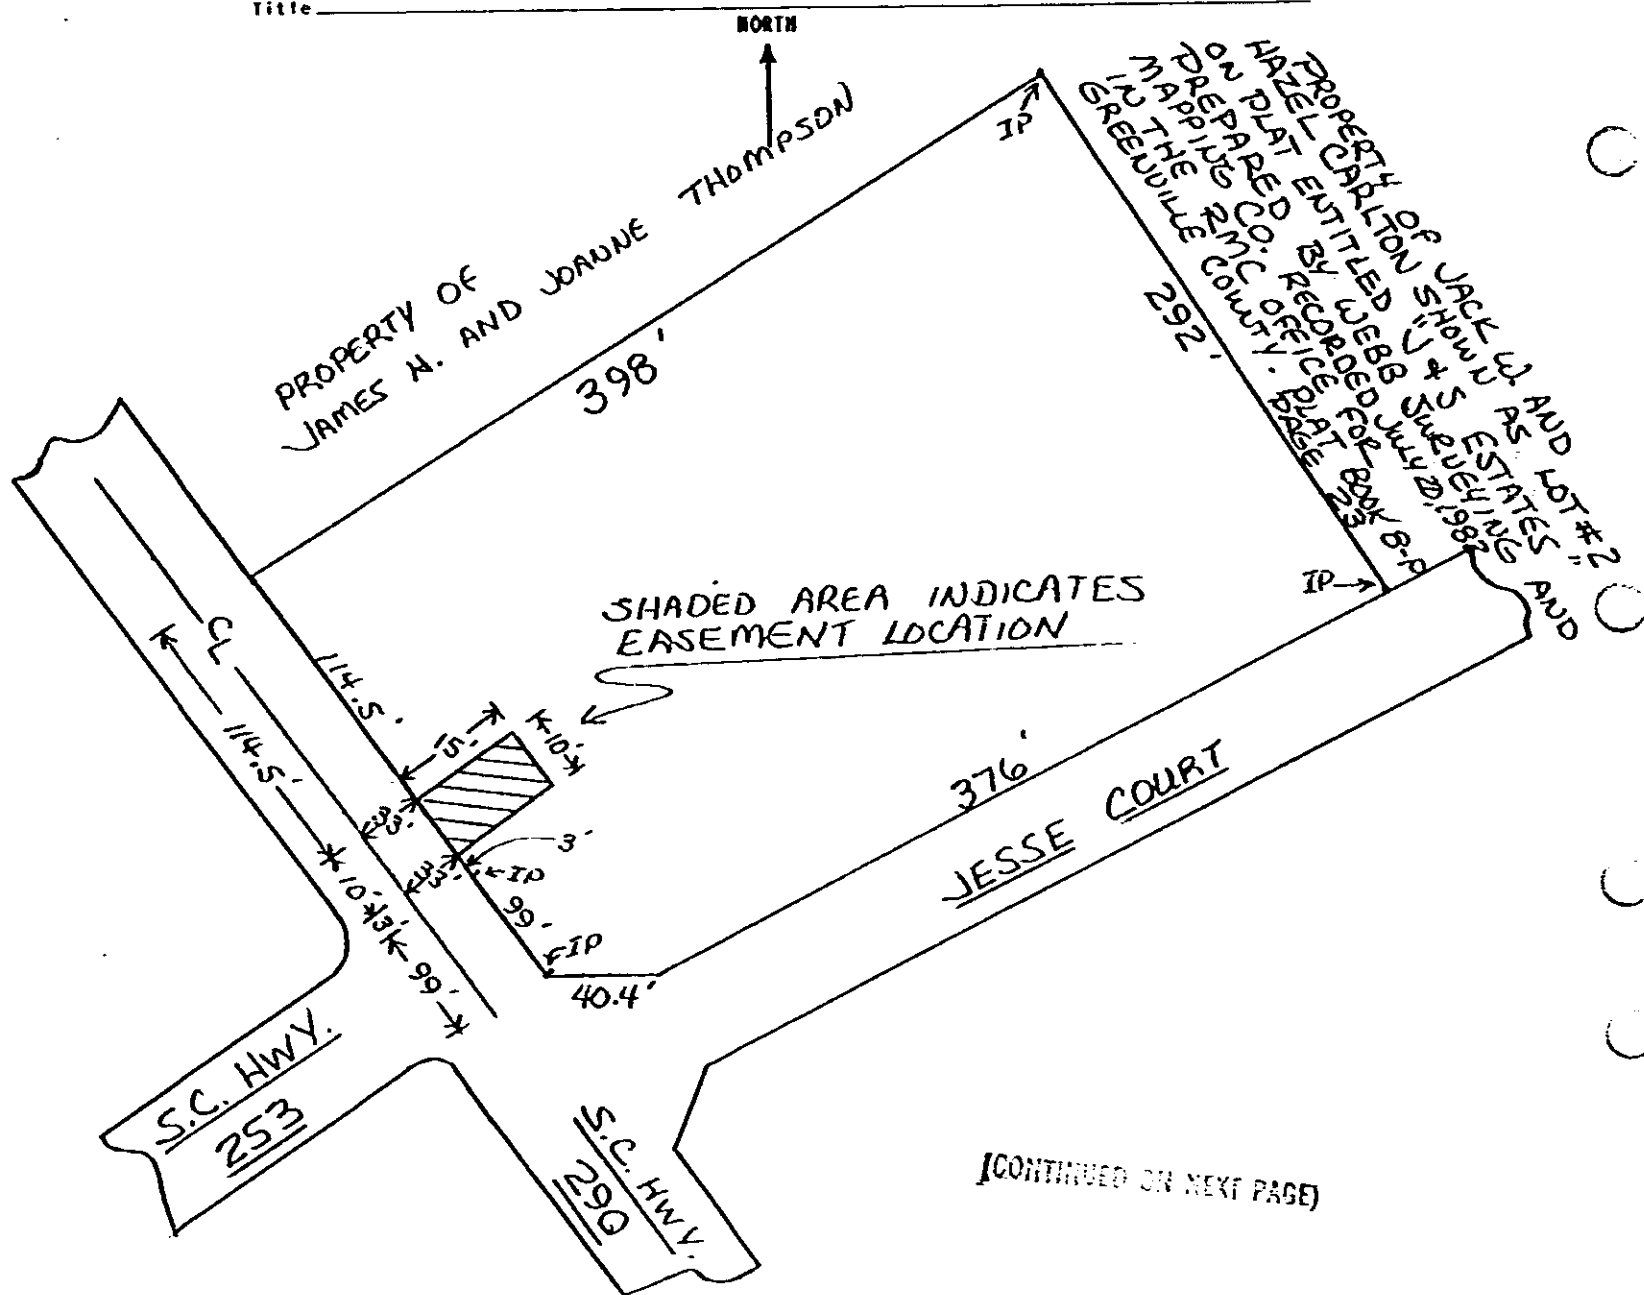

9 7 7 9

4328-124