


B I 5 0

Vol 1188 page 510


FIRST FLOOR PLAN

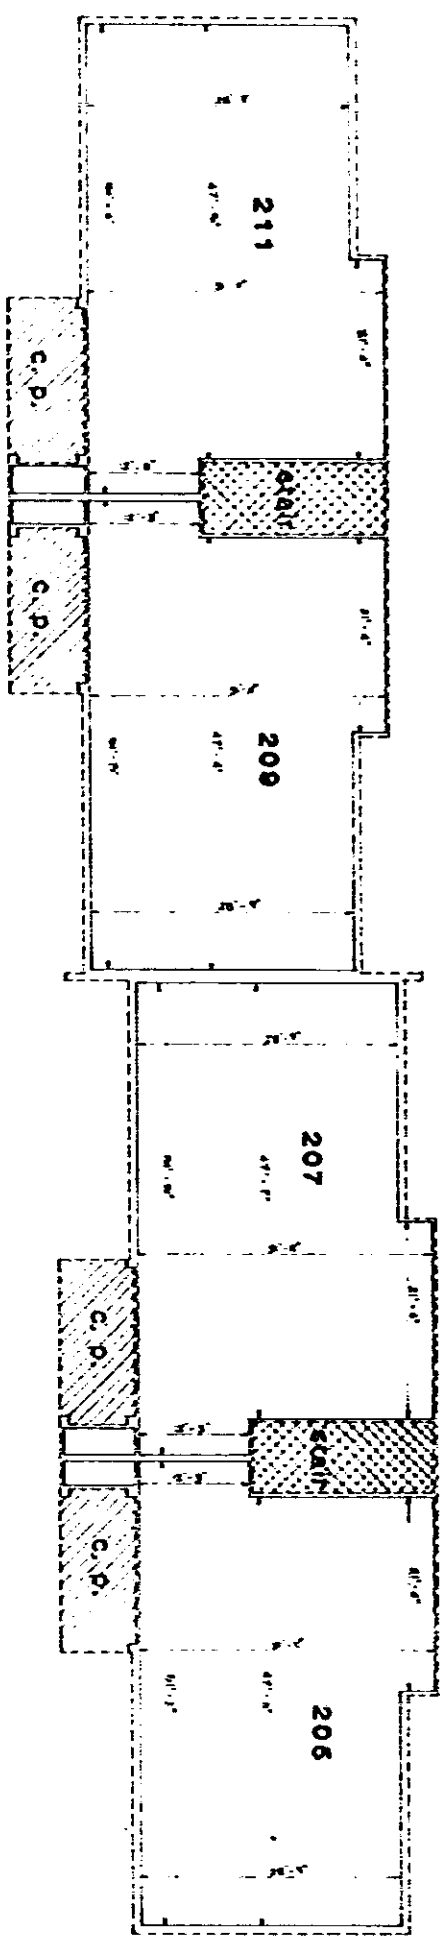

I, ORVILLE V. PLAYER, HEREBY CERTIFY THAT THE SE DRAWINGS COMPASSING THIS EXHIBIT ARE CORRECT ON THE BASIS OF THE SURVEY OF W.R. WILLIAMS, JR. AND THAT THE AS BUILT ARCHITECTURAL DRAWINGS OF MILLER/PLAYER AND ASSOCIATES, ARCHITECTS ARE AVERAGE DIMENSIONS AND SHOULD NOT BE TAKEN AS EXACT MEASUREMENTS.

ORVILLE V. PLAYER, II  
*Orville V. Player, II*  
 S.C. REGISTRATION #1099

SECOND FLOOR PLAN  
GEORGETOWN

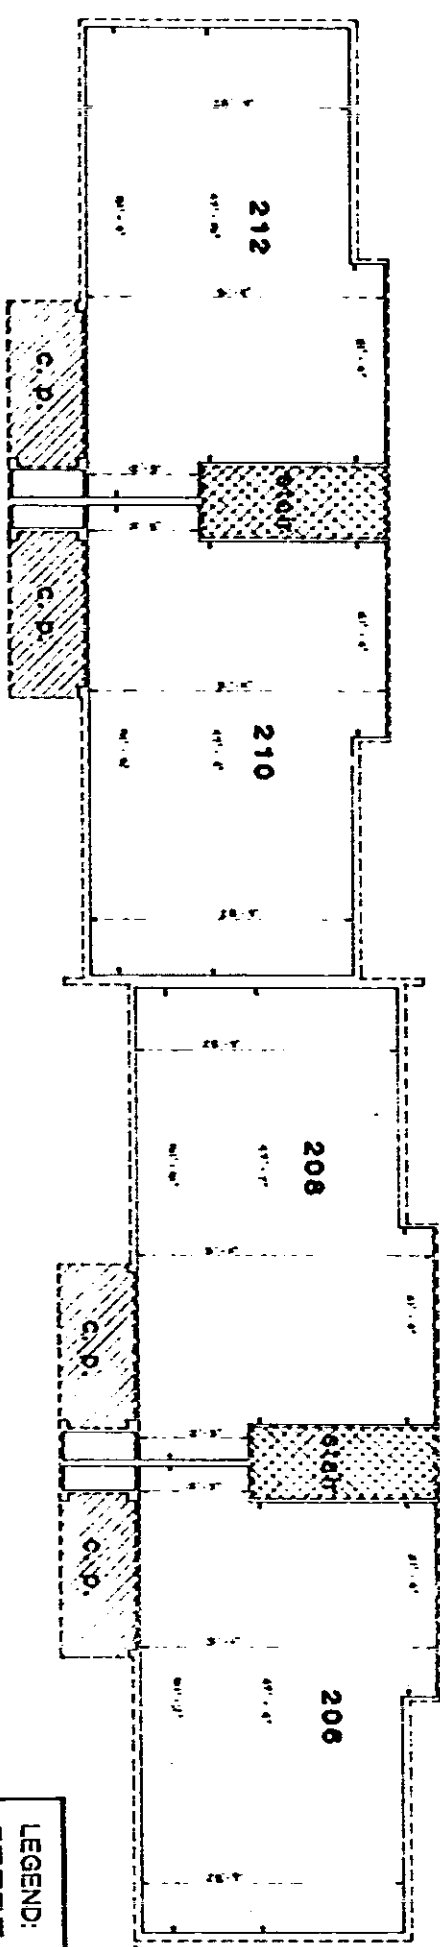

**LEGEND:**  
 - - - - - EXTERIOR WALL LINE  
 - - - - - UNIT BOUNDARY  
 - - - - - GENERAL COMMON ELEMENTS  
 [Cross-hatch pattern] LIMITED COMMON ELEMENTS  
 [Diagonal hatching] "C.P." DENOTES CONCRETE PORCH



RIVERBEND CONDOMINIUMS  
 PHASE TWO  
 HORIZONTAL PROPERTY REGIME  
 EXHIBIT B



**MILLER/PLAYER & ASSOCIATES**  
 ARCHITECTS AND PLANNERS, LTD.  
 1010 east north street, greenville, s.c.  
 James B. Miller, A.S.A. / Orville V. Player, II / Robert C. Cochran



EX-108 82674