


FOUNDATION PLAN
CHARLESTON

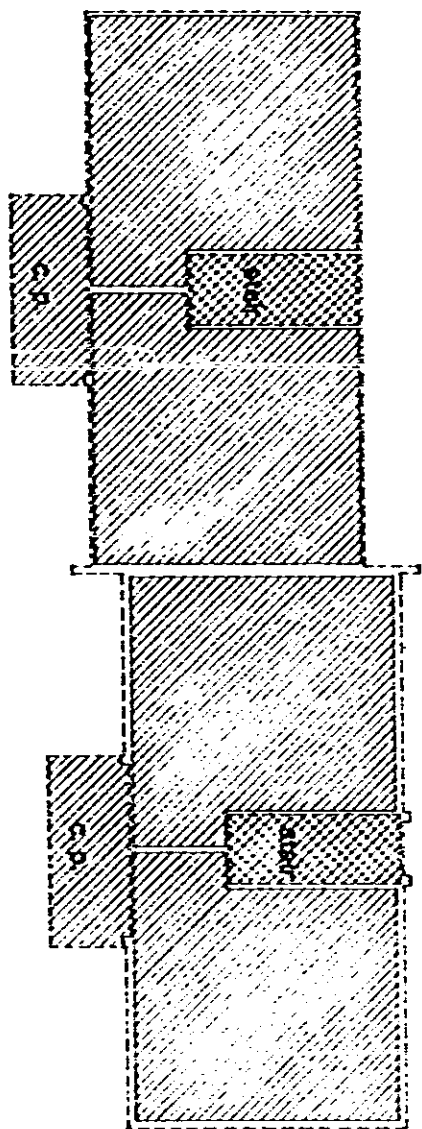

I ORVILLE V. PLAYER, II, ARCHITECT CERTIFY THAT THE 89 DRAWINGS COMPRISING THIS EXHIBIT ARE CORRECT ON THE BASIS OF THE SURVEY OF W.S. WILLIAMS, JR. AND THAT THE AS BUILT ARCHITECTURAL DRAWINGS OF MILLER/PLAYER AND ASSOCIATES, ARCHITECTS ARE AVERAGE DIMENSIONS AND SHOULD NOT BE TAKEN AS EXACT MEASUREMENTS.

ORVILLE V. PLAYER, II
S.C. REGISTRATION #11909

LEGEND:

- EXTERIOR WALL LINE
- UNIT BOUNDARY
- GENERAL COMMON ELEMENTS
- LIMITED COMMON ELEMENTS
- C. P. DENOTES CONCRETE PORCH



| | | |
|------|-------------|----|
| DATE | DESCRIPTION | BY |
| | | |
| | | |



0 5 1 9

4328-162