



FOUNDATION PLAN
L&E

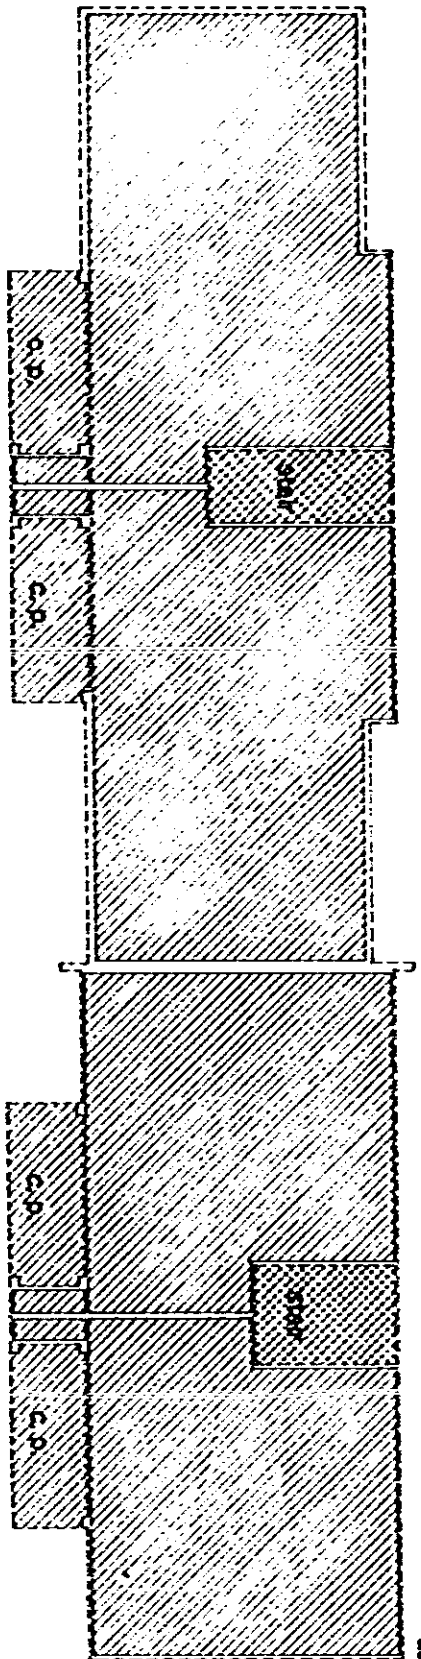

I, ORVILLE V. PLAYER, II, HEREBY CERTIFY THAT THE SO DRAWINGS COMPASSING THIS EIGHTH ARE CORRECT ON THE BASIS OF THE SURVEY OF W/A WILLIAMS, JR. AND THAT THE AS BUILT ARCHITECTURAL DRAWINGS OF MILLER/PLAYER AND ASSOCIATES, ARCHITECTS ARE AVERAGE DIMENSIONS AND SHOULD NOT BE TAKEN AS EXACT MEASUREMENTS.

Orville V. Player, II
ORVILLE V. PLAYER, II
S.C. REGISTRATION # 1599

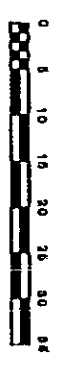

LEGEND:

- EXTERIOR WALL LINE
- UNIT EQUIPMENT
- GENERAL COMMON ELEMENTS
- LIMITED COMMON ELEMENTS
- 6" P. DEMOTES CONCRETE FORM

NO.	DATE	REVISIONS



0
5
2
9

14328-1162