


0970

Name and Post Office Address of Grantor: Roy E. Collins, Jr.
605 Arlington Road
Greer, SC 29651

Title: _____

Property is bounded where the line enters and leaves this property by the priority of:
Miller Street on the East
Mulberry Street on the West
 Authority: P-43438 Classification: R45C
 State: South Carolina
 Approved: R. J. Jylu
 Title: Segment Manager-Engineering/LAC

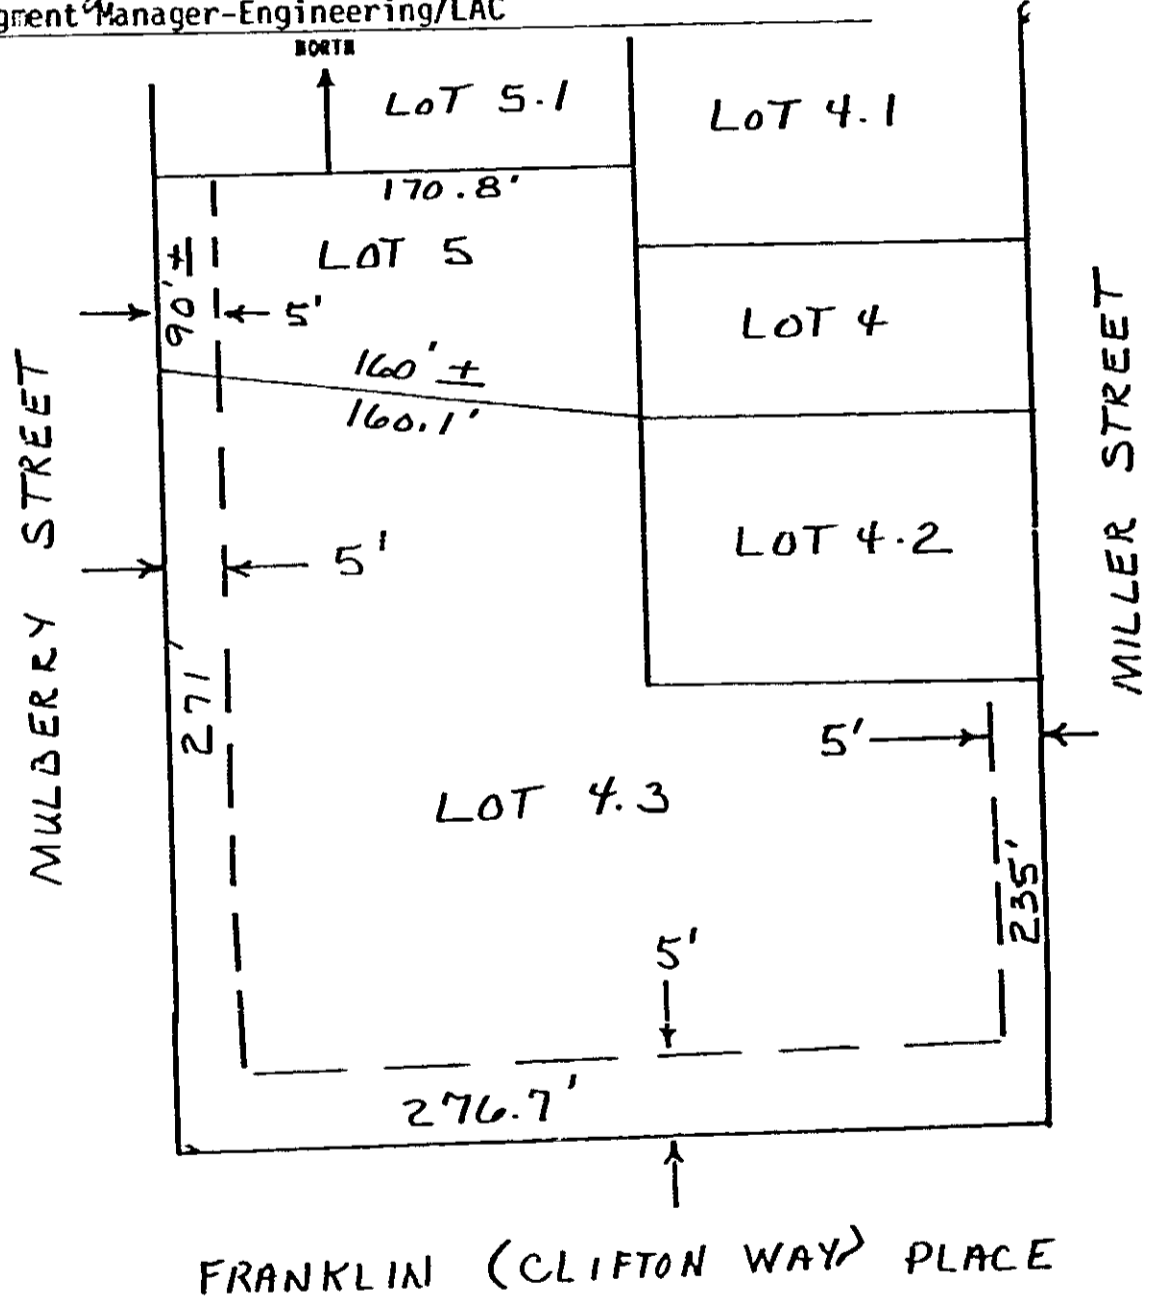

RECORDED SEP 22 1983 at 11:11 A.M.

9674

4328-1123