


PIEDMONT NATURAL GAS COMPANY, INC. Vol. 1169 Page 70.3
 GENERAL MAIN MAP CHANGE ORDER

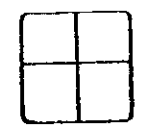


Page 1 of 1 Pages

Sketch Prepared By NRW District _____
 Normal Pressure of Gas Mains _____ General Main Map No. _____
 If Work Was Performed On An I.R. Give I.R. No. _____
 Completion Date: Month _____ Year _____
 Pipe Size _____ Pipe Type _____ Wall Thickness _____
 Pipe Spec. _____



PROPOSED 20' RIW THROUGH W.D. mobile home PARK ON
 PARCEL OF LAND DESCRIBED IN DEED BOOK 1169 PAGE 47.

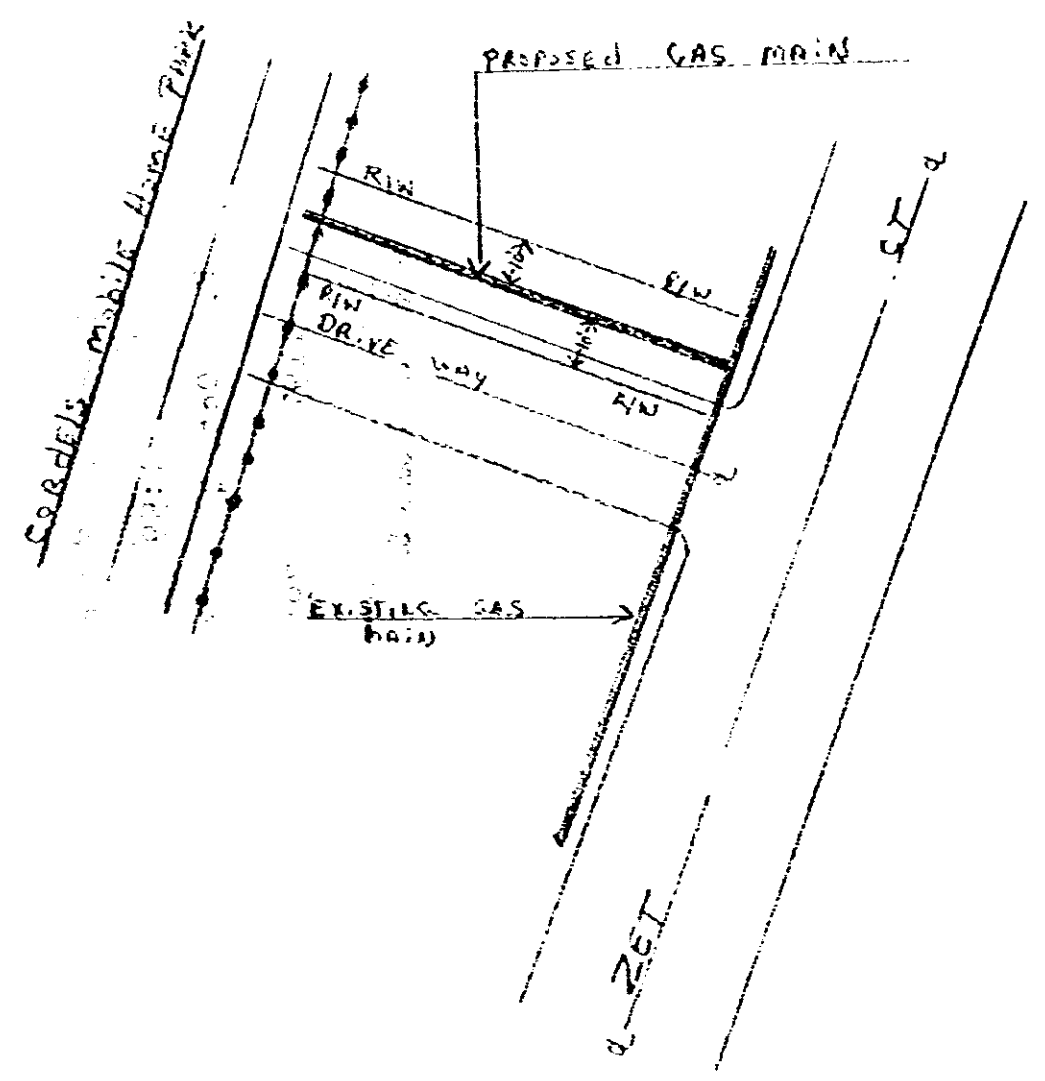

District General Main Map Corrected: Date _____ Initials _____
 Engineering Dept. General Main Maps Corrected: Date _____ Initials _____
 C-126 RECORDED at 1:59 P.M. 11130

0793

11328-112