


Vol 107

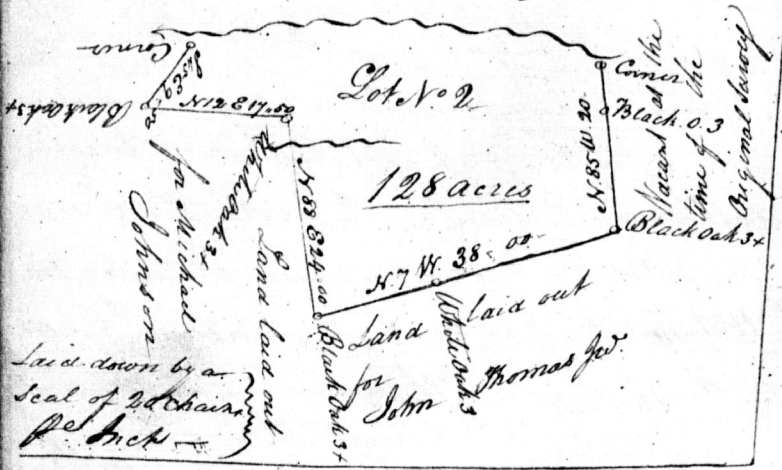

State of South Carolina

Pursuant to the directions of David Goodette Alexander Waddell George Russell Elipha Green Esq<sup>r</sup> and George Underwood Commissioners appointed by the Honorable Court of Greenville District to Divide the Real Estate of Forrest Hudson Dec<sup>d</sup> I have laid out the above Tract of One hundred and Twenty Eight acres of Land for Henry Hudson one of the

Heirs of the said Dec<sup>d</sup>. It being the Lot drawn by him after the Division Bounded southwardly by land laid out Michael Johnson. Eastwardly by land laid out for John Thomas Junr. northwardly by vacant land at the time of the Original Survey and Westwardly by a branch of Lot No. 1. and hath such shape and marks as the above plat represents. Certified the 6<sup>th</sup> day of December 1805

Recorded the 14<sup>th</sup> day of March 1807

Geo. Salmons D. Sec.

462  
State of South Carolina Greenville District.

I know all men by these presents that I Warwick Bristor of the State and District aforesaid for and in consideration of the sum of Eight hundred and seventy five Dollars to me paid by Joel E. Grace of the State and District aforesaid. Hath bargained and sold and by these presents do bargain & sell unto the said Joel E. Grace a certain tract or Parcel of Land lying and being in the State and District aforesaid on the waters of Mountain Creek. Beginning on a red oak N. 89. W. 61 Ch<sup>r</sup> to a hickory & thence N. 10. E. 85. 50. adjoining Capt. Geo. Spacers Land to a hickory running to Randol Smith fifty acres on the North end thence S. 65. E. 41. Ch<sup>r</sup> to a stake on Drury Hodges line thence S. 25. E. 25 Ch<sup>r</sup> to a hickory adjoining vacant Land, thence S. 55. E. 55 Ch<sup>r</sup> to a red oak thence S. 10. W. 43. Ch<sup>r</sup> to the Beginning. which parcel or tract of land as above Described Containing by Estimation 350 acres be the same more or less. With all the rights Members Hereditaments and appurtenances to the said Premises Before going or in any wise Accidental or appertaining to the said Joel E. Grace his heirs & assigns. And I do hereby bind myself to warrant and forever defend the said Premises to the said Joel E. Grace or his heirs against myself and my heirs and against every other Person whomsoever Lawfully claiming or to claim the same or any part thereof Except the Methodist Meeting House on said Premises & two acres of land Round it which is hereby strictly reserved for the use of said Society for or as long as they Chuse to continue it a Place of Public worship - Witness my hand and seal this 27<sup>th</sup> day of September in the year of our Lord 1806. & in the Independancy of the United States of America the 31<sup>st</sup> year. Signed Sealed & Delivered in the Presence of

John Grace James Grace

Warwick Bristor

State S. Carolina Greenville District I Hudson Borry a Justice of the Quorum for hereby Certify unto all whom it may concern that Mary Bristor wife of the within named Warwick Bristor did this day appear before me and upon being Privately & Separately Examined by me did declare that she does freely voluntarily and without any Compulsion do and

(Seal)