


The State of South Carolina Pendleton District: I
 one of the Justices of the Quorum
 for the said district do hereby certify unto all whom it
 may concern that Harriet Earle the wife of the
 within named Samuel Earle did this day appear
 before me, and upon being privately and separately
 examined by me, did declare that she does freely
 voluntarily and without any compulsion dread
 or fear of any person or persons whomsoever renounce
 release and forever relinquish unto the within named
 Baylis John Earle his heirs and assigns all her
 Interest and Estates, and also all her right and
 claim of Dower of, in, or to all and singular the
 premises within mentioned and released.
 Given under my hand and seal this
 day of _____ in the year of our Lord one thousand
 Eight hundred and _____

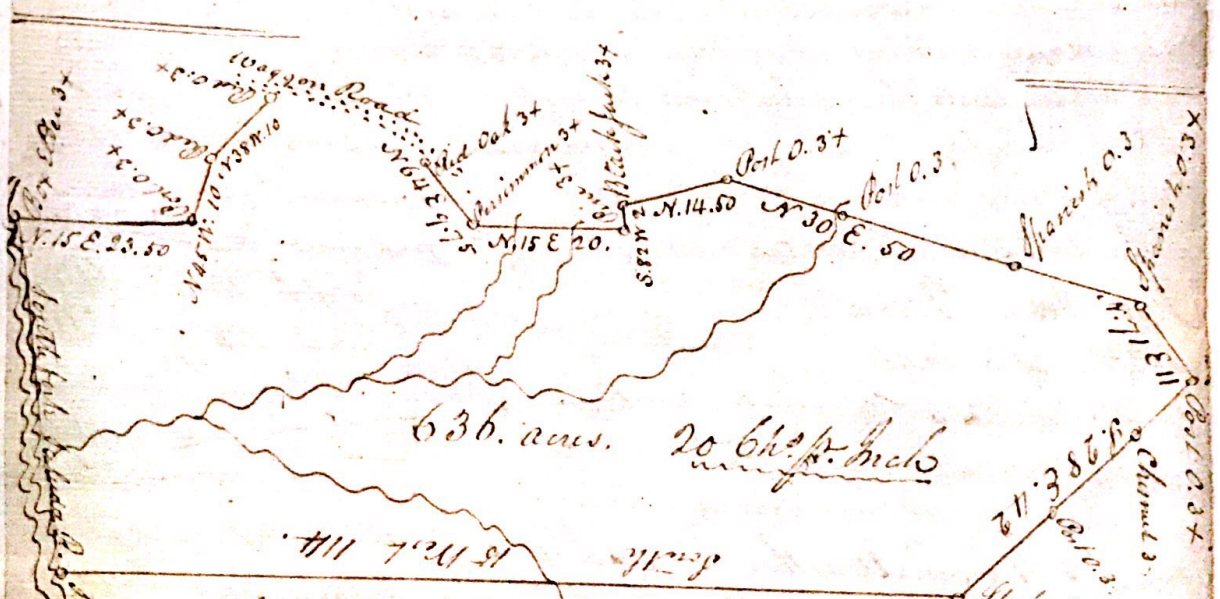

I do certify that at the request of Samuel Earle
 I have advertised and laid out for him Six
 hundred and thirty six acres of Land having such shape
 and marks callings and boundings as the above plat
 represents, this 22^d day of April 1812 James Jell D.
 41
 Recorded the 4th day of August 1817