


Lord one thousand eight hundred and forty and sixty fifth year of the independence of the United States of America signed sealed and delivered in presence of  
 of Robt E. Smith  
 of John W. Taylor  
 Francis Chandler  
 Josiah Chandler  
 State of N. Carolina personally came Joel E. Smith before me the undersigned Justice and made oath that he saw Francis Chandler & Josiah Chandler sign seal and deliver the within deed of conveyance to Adam Jones for the use and purpose within mentioned and that John W. Taylor was a subscribing witness with himself to the same sworn to and subscribed this 11<sup>th</sup> day of December 1840  
 Before me John Townsend J. D.  
 State of N. Carolina

I, John Townsend one of the Justices of the Greenville District do hereby certify unto all whom it may concern that Elizabeth Chandler wife of the within named Josiah Chandler did this day appear before me and upon being privately & separately examined by me did declare that did freely & voluntarily and without any compulsion dread or fear of any person or persons whomsoever renounce release and forever relinquish unto the within named Adam Jones his heirs and assigns all her interest & estate also all her right & claim of dower of in or to all & singular the premises within mentioned and released

Given under my hand & seal this 11<sup>th</sup> day of December 1840  
 John Townsend. J. D.  
 Elizabeth Chandler

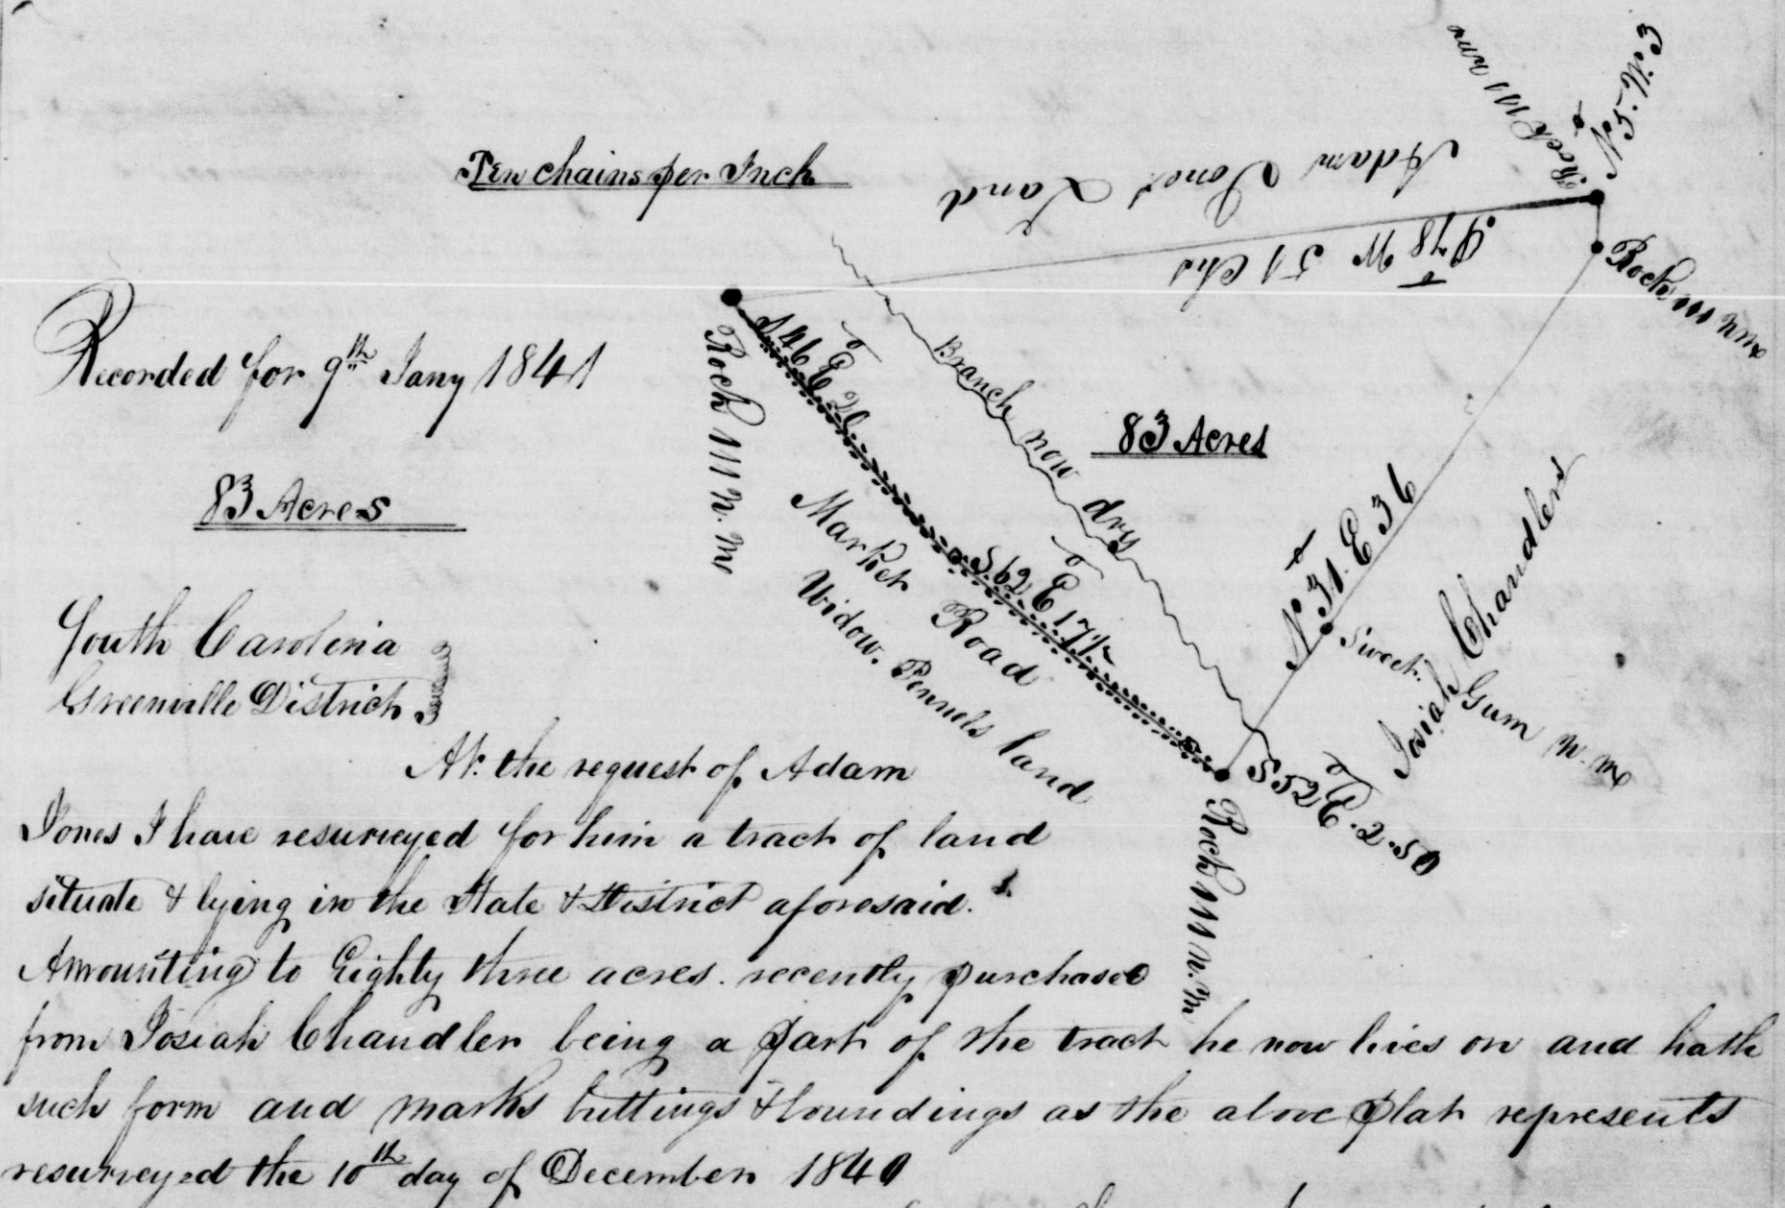

Recorded for 9<sup>th</sup> Jan 1841  
83 Acres

South Carolina  
 Greenville District  
 At the request of Adam Jones I have surveyed for him a tract of land situate & lying in the State & District aforesaid amounting to eighty three acres recently purchased from Josiah Chandler being a part of the tract he now lies on and hath such form and marks buttings & soundings as the above plat represents surveyed the 10<sup>th</sup> day of December 1840

By Samuel Moore. C. Sur.