


# MEBEE LANDS

OF

MT. CITY LAND & IMPROVEMENT CO.

GREENVILLE S. C.

*Revised Plat  
Capt. J. J. J. J.*

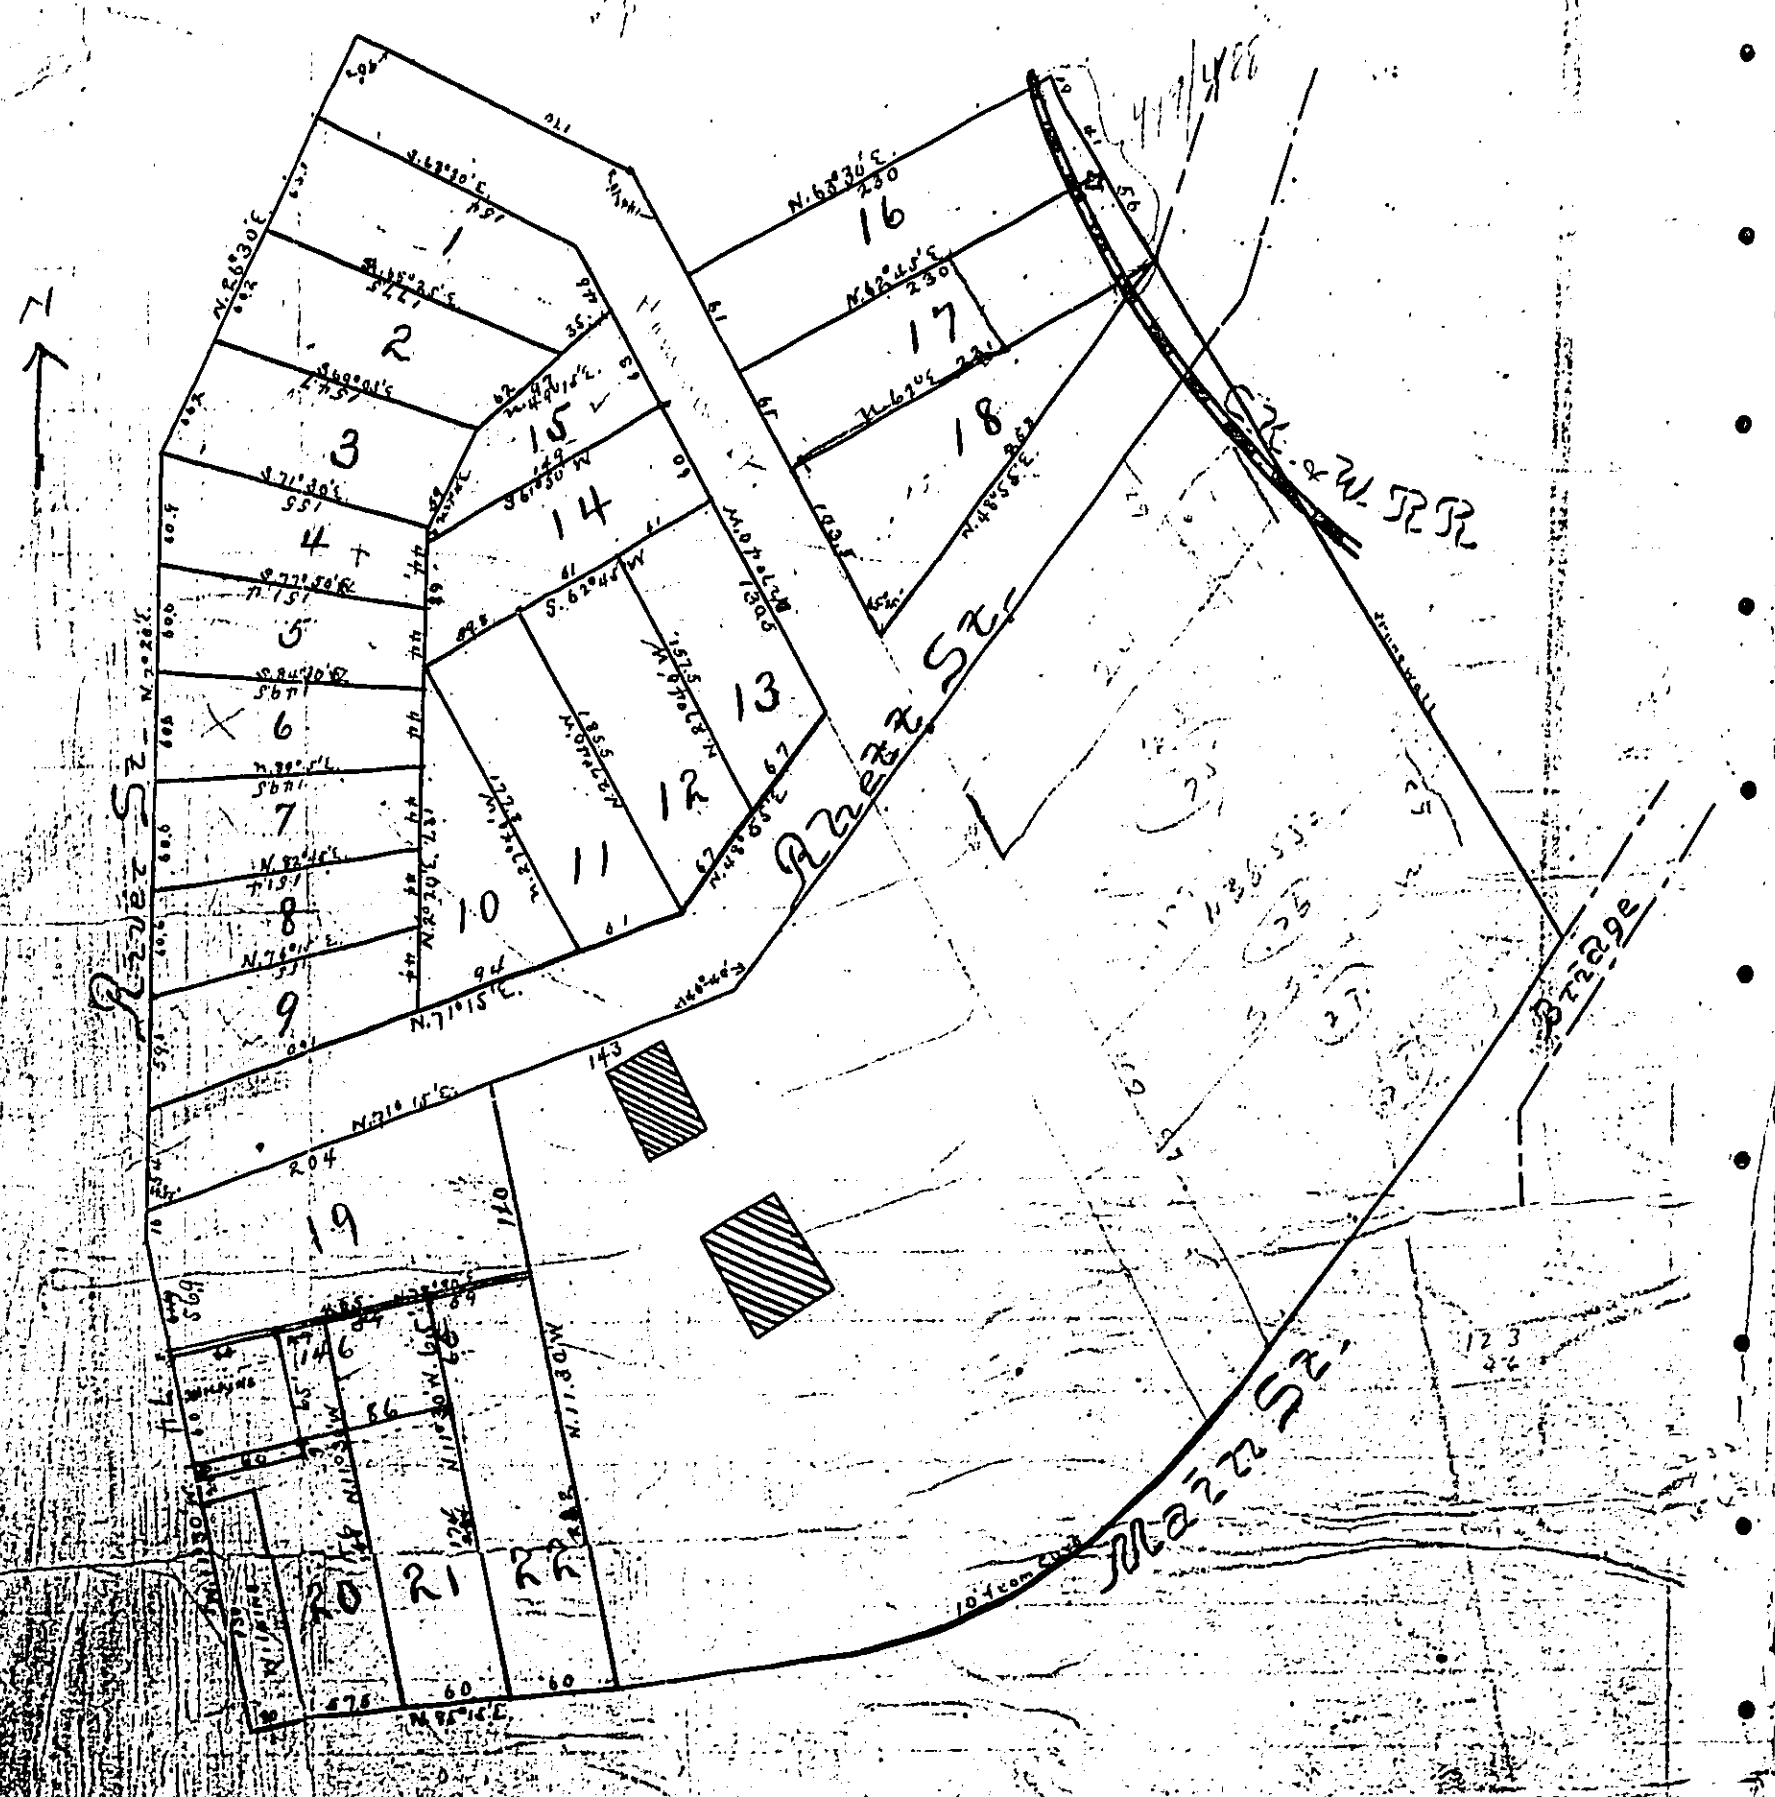

*note - Changes have been made in Red*

