
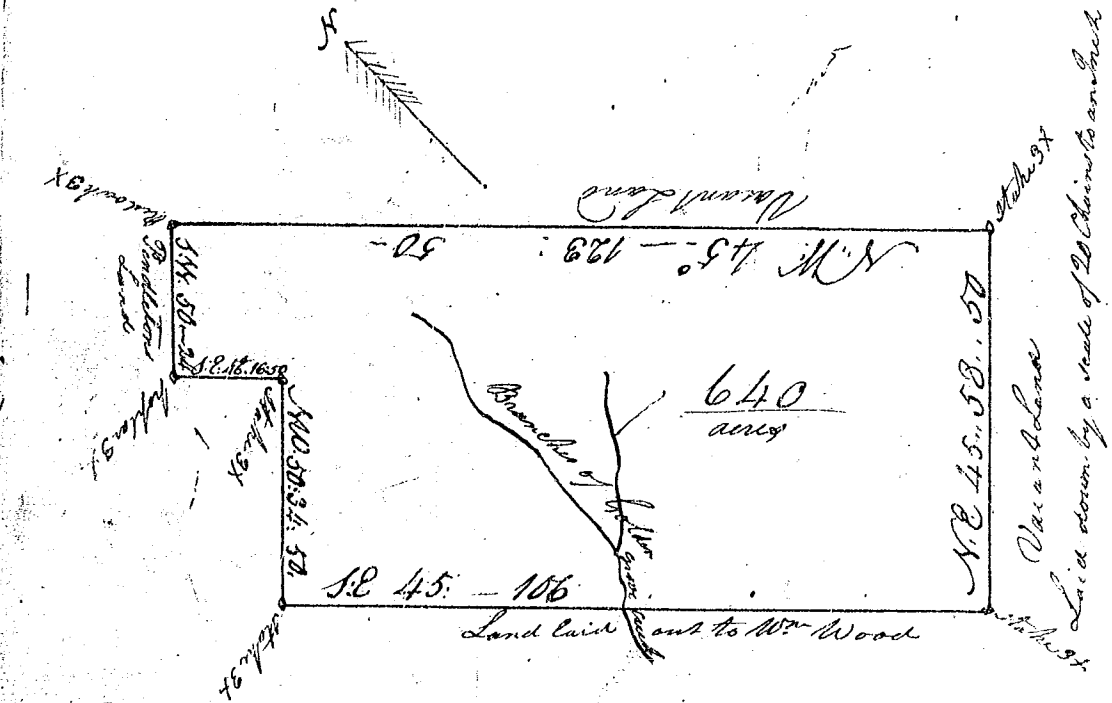


South Carolina  

 Surveyed on the 26<sup>th</sup> day of May 1784  
 Thomas Lewis Esq.  
 Recorded on the 10<sup>th</sup> day of June 1784

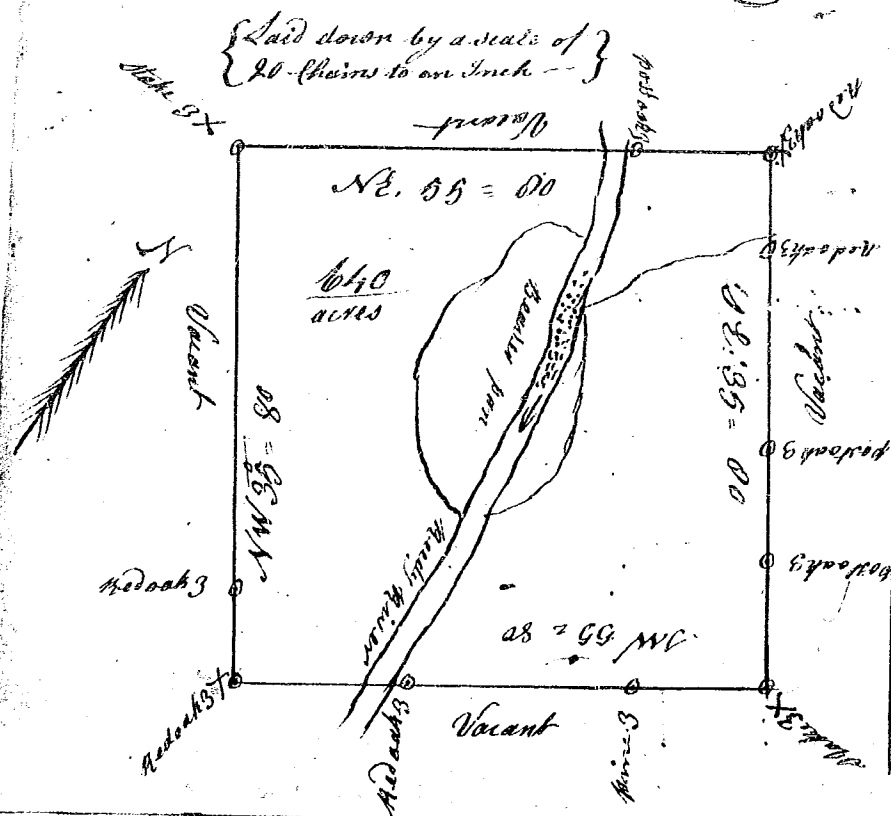

South Carolina  

 Surveyed on the 25<sup>th</sup> day of May 1784  
 Thomas Lewis Esq.  
 Recorded on the 10<sup>th</sup> day of June 1784