(31)

## State of South Carolina

Pursuant to a warrant to me directed by John Thomas Esqr Commissioner of Locations for the district of the north side of Saluda, I have surveyed & laid out unto Henry Benson a tract of land containing 640 acres Situate lying & being above the old Indian Boundary, & on both sides of Enoree River & known by the name of Rutes Canebrake, and hath such Shape & marks as the above plat Represents.

Surveyed & Certified by me this 25th May 1784

James Seaborn D.S.

The above River not navigable

Recorded the 5th July 1784

delivd to Majr Faner

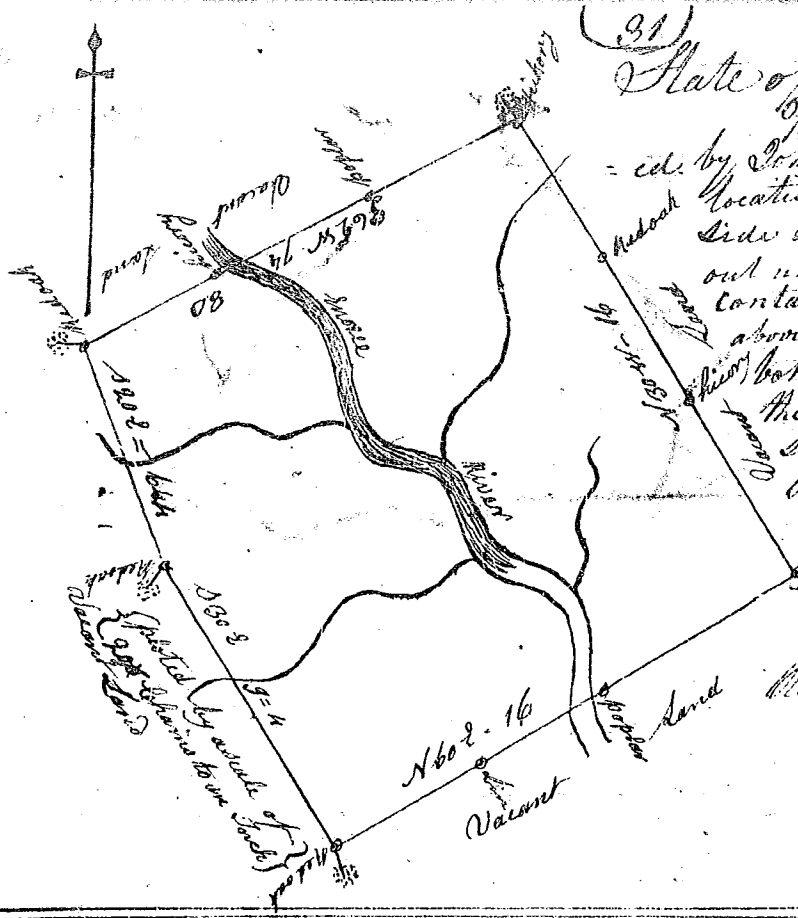
Vacant Land
Vacant Land
Vacant Land
Vacant Land
Vacant Land
Vacant Land
Vacant Land
Vacant Land
River
Creek
Creek
Creek