


South Carolina Pursuant to a precept from some


(145)

Directed by John Bremer Esq. Depy. Secy. Genl. Bearing date the first Tuesday in Oct. 1772. I have admeasured and laid out unto William Taylor a tract of Land containing 200 acres situate and being in Charon County on the Waters of Little River to the West part on East of the said W<sup>m</sup> Taylor and part on East Land N<sup>o</sup> on Lewis Qualls land & the land all other sides on Vac<sup>t</sup> land and hath such shape and marks as the Annex<sup>d</sup> plat Represents. Certify<sup>d</sup> for the 22<sup>d</sup> day of Dec<sup>r</sup> 1772  
Recorded the 22<sup>d</sup> Sept<sup>r</sup> 1784 Deliv<sup>d</sup> to W<sup>m</sup> Taylor

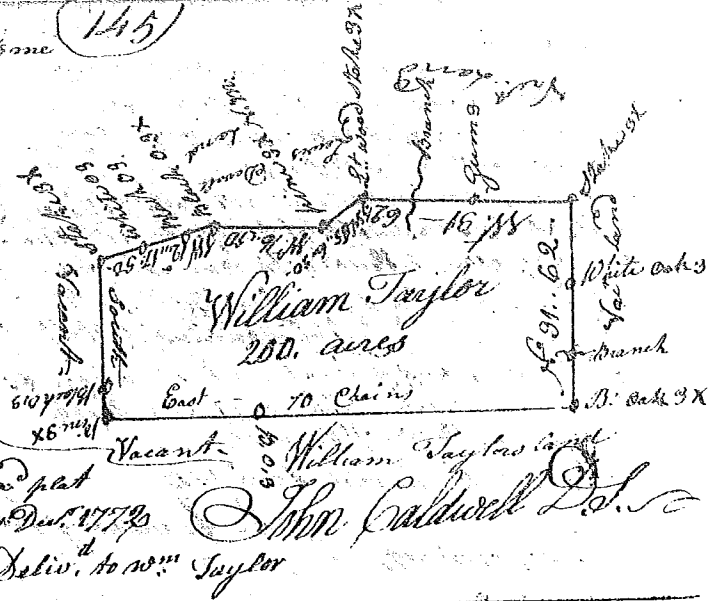

South Carolina Pursuant to a precept to some

Directed by John Bremer Esq. Depy. Secy. Genl. Bearing date December the 1<sup>st</sup> 1772. I have Admeasured and laid out unto William Hamrah a tract of Land containing one hundred and Fifty acres situate in Charon County on the Waters of Deacons Creek, butting and bounding to the S. W. on lands of Alex<sup>r</sup> Farmon & land of one Winters, and Ming land, to the N. E. on Vac<sup>t</sup> land to the N. E. on Richard Bowers and Vacant land & to the S. E. on said William Hamrah and hath such shape and marks as the Annex<sup>d</sup> plat Represents. Certify<sup>d</sup> for this 16<sup>th</sup> of Dec<sup>r</sup> 1772  
Recorded the 23<sup>d</sup> Sept<sup>r</sup> 1784 Deliv<sup>d</sup> to W<sup>m</sup> Hamrah

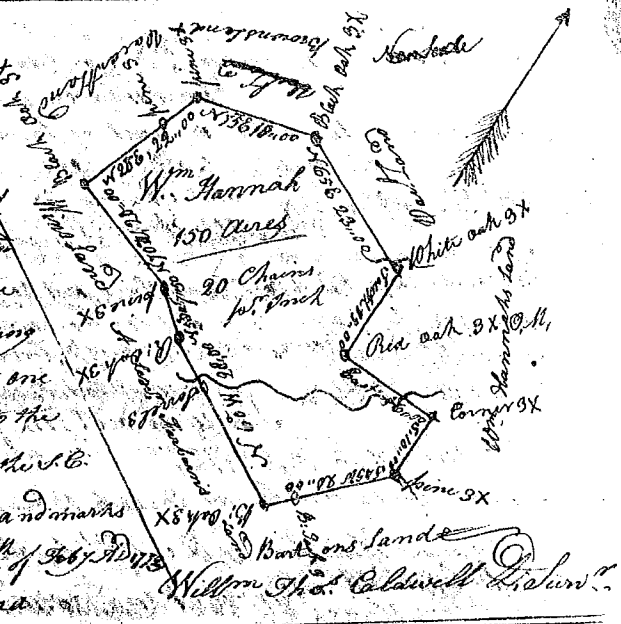

South Carolina Pursuant to a precept to some

Directed by John Bremer Esq. Depy. Secy. Genl. Bearing date 9<sup>th</sup> day of Oct 1774. I have Admeasured and laid out unto Abraham Neighbour a tract of land containing two hundred acres situate and being in Charon County on the Waters of Little River butting and bounding S. W. on land of David Anderson N. on land of Charles Allen all other sides bound on Vacant land and hath such shape and form and marks as the Annex<sup>d</sup> plat Represents. Certify<sup>d</sup> for the 16 Day of Dec<sup>r</sup> 1774  
Recorded the 23<sup>d</sup> of Sept<sup>r</sup> 1784 Deliv<sup>d</sup> to Bardsy Deuell by Neighbour's order

