


State of South Carolina (212)

Pursuant to a warrant from John Thomas Esq. Com. of Locations in Ninety Six District South of Saluda River dated the 23rd of Sept. 1784


Recorded the 19th Dec. 1784 - **Henry G. Moore** (Delivered to John Miller the same day it was recorded)

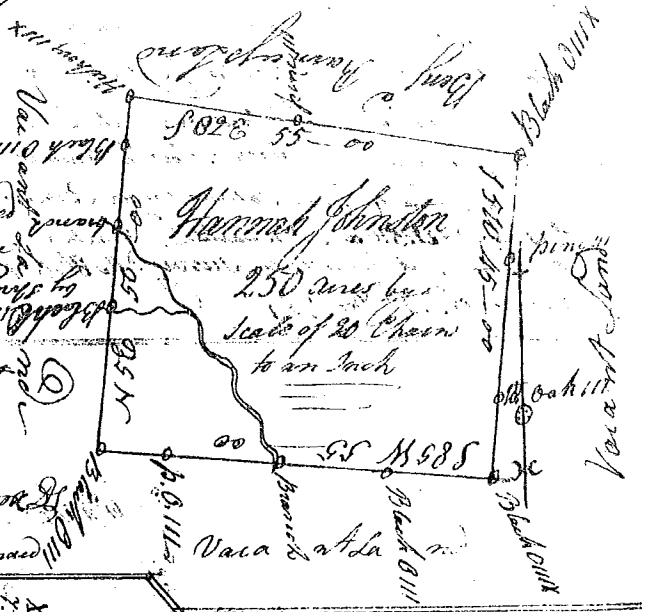


State of S. Carolina

Ninety Six District

Pursuant to a warrant to me Directed by John Thomas Esq. Commissioner of Locations for the District of the north side of Saluda River: I have Surveyed and laid out unto

William Wood a Tract of Land containing 440 acres. Situated being and being below the ancient Boundary on the first Boundary S.W. by William Wood's Land, all other sides Vacant. I have such Stake & marks as the Annex^d plat Represents. Surveyed the 24th of Oct. 1784

Recorded this 19th Dec. 1784

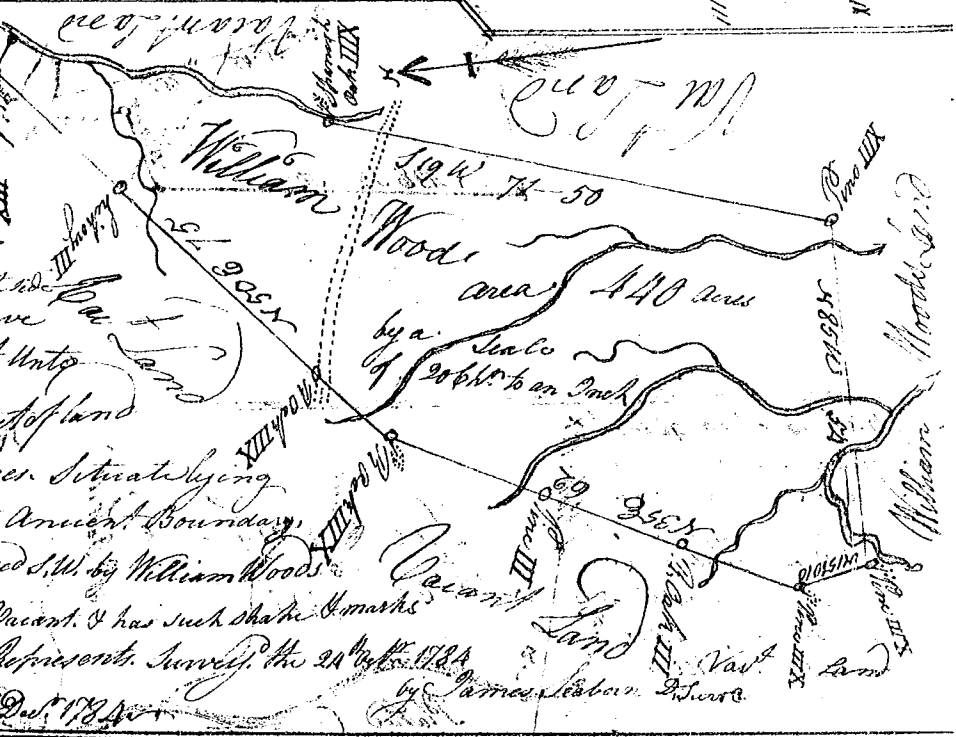

State of S. Carolina

Ninety Six District

Pursuant to a warrant to me Directed by John Thomas Esq. Commissioner of Locations for the District of the north side of Saluda River: I have Surveyed and laid out unto

John Cass a Tract of Land containing four hundred acres, situated being and being below the ancient Boundary on the sides of Duck Creek of the River. Including the Improvement of said John Cass and Allen Hamilton bounded on all sides by Vacant Land. and such Stake & marks as the above plat Represents. Surveyed the 8th day of Oct. 1784

