



State of South Carolina Pursuant to a Warrant from John Thomas Esq. Com. Sec. dated the 11th Oct. 1784. I have admeasured and laid out unto John Thompson Esq. a Tract of Land containing 148 Acres. situate in 96 District East of the old Boundary on both sides of Minihons Creek of the Waters of Broad River. Bounding on all sides on Red Land and hath been found and marked as the above

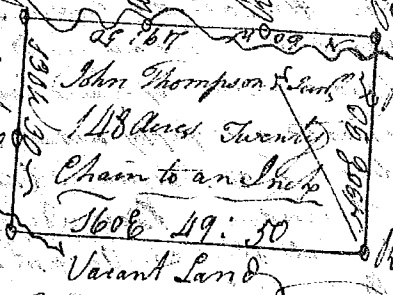

State of Carolina 96 District East of the Ancient Boundary. Pursuant to a Warrant from John Thomas Esq. Com. of Locations July 1st 1784. I have admeasured and laid out unto Thomas Bearden a Tract of land containing One hundred Acres. situate lying on a small Branch of Tygar River. Bounding to the E. by Ralph Jacksons Land all other sides vacant land and hath been found and marked as the above

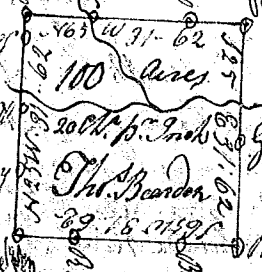

State of Carolina 96 District East of the Ancient Boundary line, Pursuant to a Warrant from John Thomas Esq. Commissioner of Locations bearing Date the 25th Sept. 1784. I have admeasured & laid out unto Lewis Bobo a Tract of land containing two hundred Acres lying on a small Branch of Tygar River Bounded to the South by Peter Neppowis land W. by Charles Longhears Land N. by Jonathan Matthews land E. by Lewis Bobos Land and hath been found & marked as the above



Survey of the 31st Sept. 1784
 Recorded the 18th January 1785
 Andrew Thomson Esq.
 Surveyor to His Bearden