

State of Carolina (9396)

Pursuant to a warrant from John Thomas Esq. Comptroller dated the 1st Jan 1788,


I have admeasured and laid out unto Arthur Simpson a tract of land containing 150 acres

Situate in Union County on the small branches of Fairforest. Bounded wholly by Arthur Parks land &c. by Charles Goodwin land &c. by Jo. Parks land and all other sides by the said Arthur Simpson & vacant land

and hath full form & marks as the above plat represents

Surveyed the 17th Jan 1788, Andrew Tomson Ds

Approved the 14th February 1788, John McElwaine

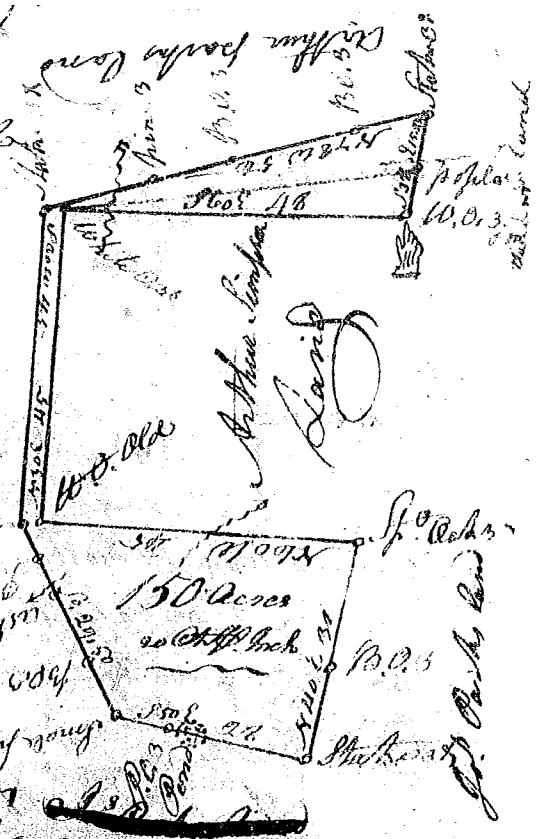

State of Carolina

Pursuant to a warrant from John Thomas Esq. Comptroller of the Treasury, I have admeasured & laid out unto Jacobson Porter a tract of 310 acres of land Situate in the County of District on the South side of Broad River on Browns Creek & hath creek & hole marks, Buttings and brown readings as the above plat represents

Surveyed the 27th Jan 1788

Charles Sims Ds

Recorded the 15th Feb 1788

