



State of South Carolina, Pursuant to a  
 Warrant from John Thomas Commissioner of  
 Location I have admeasured and laid out unto  
 John Palmer a tract of Three Hundred and  
 Ninety Two acres of Land situate in  
 Ninety Six District on Buffelton Creek  
 a branch of Sixforest bounding NW on  
 Edm. Hays land SE on land laid out  
 for Hensley Holland & Mill. Tappan & Nelson  
 James Little and land laid out for  
 arch. Ford Evan Thomas & Edm. Hays land  
 all other sides on Vacant Land, and hath  
 such shape and Marks as the above Plat  
 Represents, Survey: 18th Febry 1785  
 recorded 23<sup>rd</sup> Febry 1785.  
 Ben. Glenn Depy

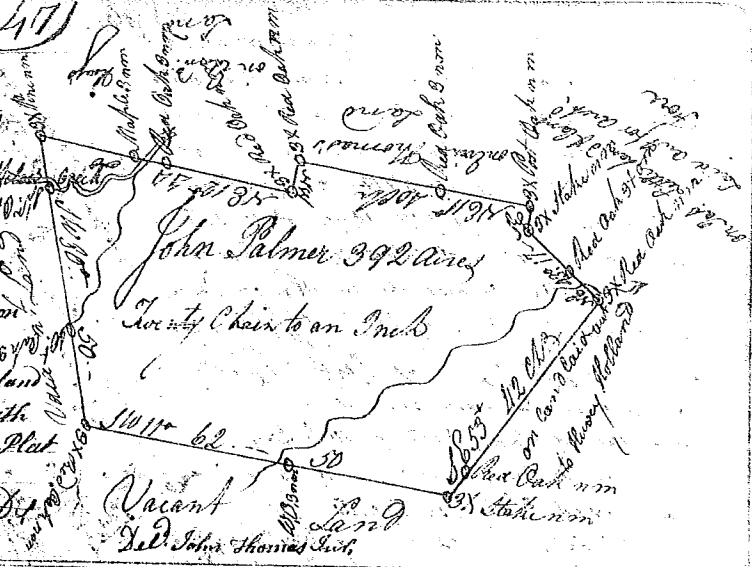

State of S<sup>c</sup> Carolina Pursuant to a warrant from John Thomas  
 Commissioner of Location I have admeasured and laid out  
 unto W<sup>m</sup> Williams a tract of one hundred acres of Land  
 situate in Ninety Six District on waters of Roopers Creek  
 bounding NW on W<sup>m</sup> Williams land SE on Henry  
 Longs land SE on Henry Longs land SE on William  
 Williams land, all other sides on Vacant Land,  
 and hath such shape and Marks as the annexed  
 Plat Represents, Survey: 17th Febry 1785 Ben. Glenn Depy  
 recorded 23<sup>rd</sup> Febry 1785  
 Del. John Thomas Sur

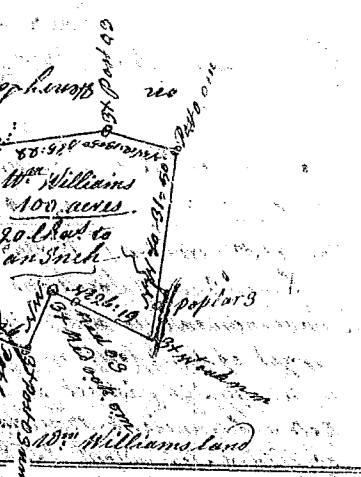

State of S<sup>c</sup> Carolina Pursuant to a warrant from John Thomas  
 Commissioner of Locations, I have admeasured and laid out  
 unto John Smith blacksmith a tract of Land containing three  
 hundred and thirty acres lying on the small branches  
 of M<sup>r</sup> Elveanss Creek, bounded SW by the said John Smiths  
 Land, N by John Shanks land NW by John Waffords  
 land, all other sides Vacant Land and hath such shape and  
 Marks as the annexed Plat Represents  
 Survey: 18<sup>th</sup> Janry 1785  
 recorded the 23<sup>rd</sup> Febry 1785  
 Andrew Thomson Depy  
 Del. John Thomas Sur

