State of S^th Carolina } Pursuant to a warrant
Laurence County } from John Thomas Commissioner of Locations Dated the 29 Jan^y 1785, I have admeasured and laid out unto John Moss Two hundred acres of land below the ancient Boundary in Laurance County, Bounding N^th on Holoway Power S^th on Currey's Land, and the other sides not known, and hath such form and Marks as the above Plat Represents,
Survey^d the 11 april 1785,
John Rodgers D.S.
Recorded the 15th april 1785,

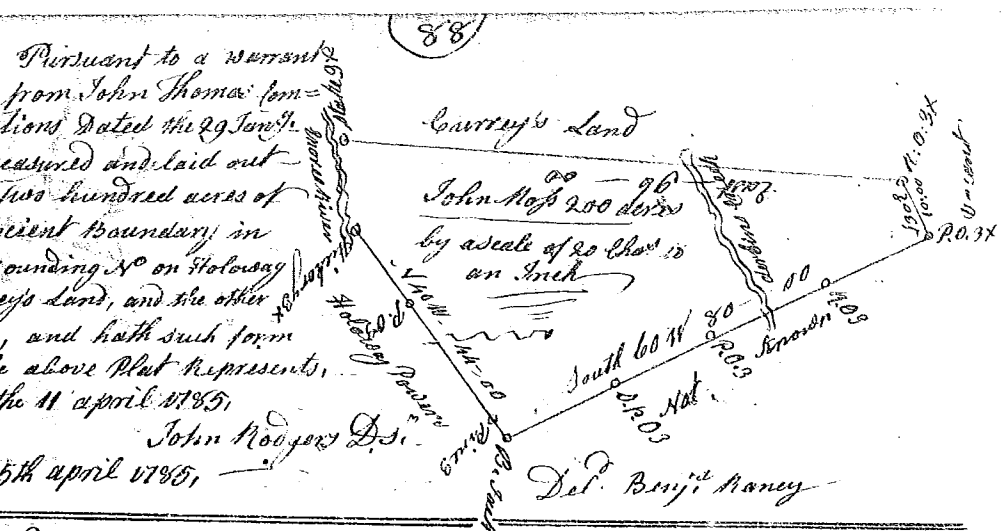

State of S^th Carolina } Pursuant to a warrant.
Laurance County } from John Thomas Commissioner of Locations dated 14th april 1785, I have admeasured and laid out unto Jonathan Clarke a tract of Six hundred and forty acres of land, in the County aforesaid, luting and bounding on Enoree River, below the ancient boundary NW on 19^th Humphreys, S on Edward Pugh & on Holaway Power, and the other Sides unknown, and Hath such shape and Marks and form as the above Plat Represents
Survey^d the 15th april 1785,
John Rodgers D.S^r
Recorded the 15th april 1785

Del^d Martin Williams

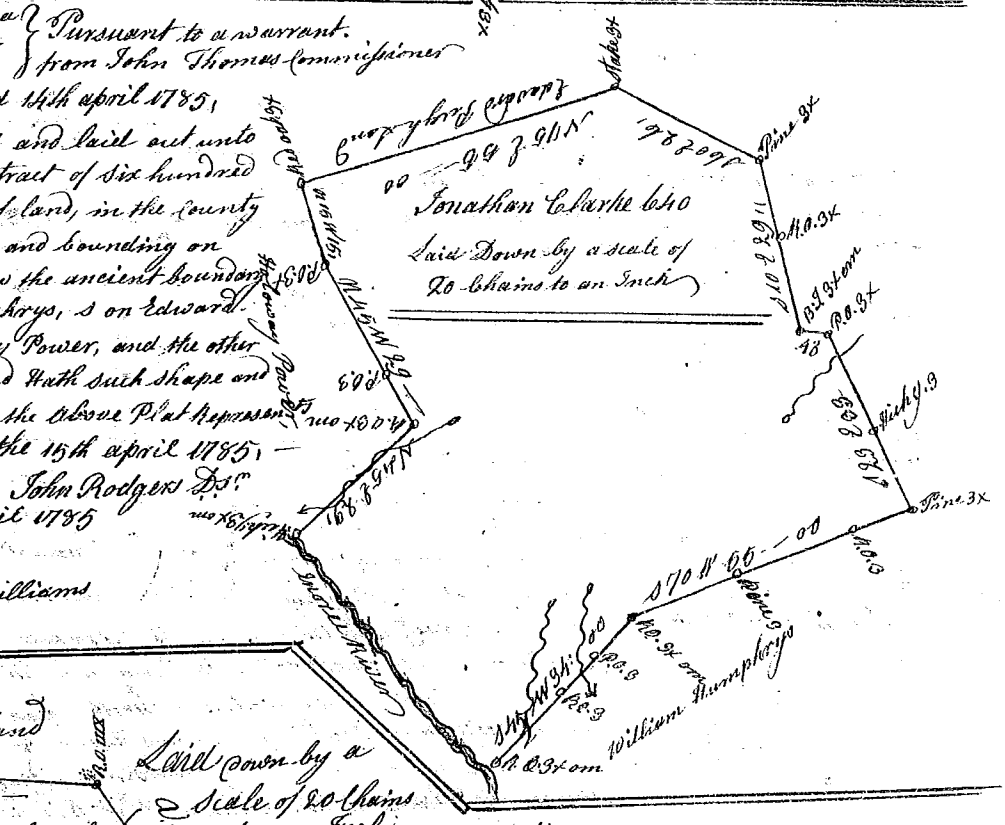

State of S^th Carolina 96 District, —
Pursuant to a warrant from John Thomas, Esq^r Commissioner of locations for the Dist^t of the N^th side of Saluda River, I have survey^d and laid out unto Abednigo Chandler a tract of Land containing 300 acres situate lying and being above the ancient Boundary line, on both sides of Brushey Creek, of Reedy River — Bounded Ewardly by land laid out By Lewis, all other sides Vacant, and Hath such shape and Marks as the above Plat^t Represents. Survey^d 5 Nov^r 1784 —
James Seaborn D^r.
Recorded 16 april 1785. —

State of S^th Carolina 96 District } Pursuant to a warrant to me directed by John Thomas Esq^r Commissioner of Locations for the Dist^t of Saluda River. I have survey^d and laid out unto William Miller heir at Law of Philip Miller dec^d a tract of land containing 200 acres on the County situate lying and being above the ancient boundary line, on both sides of the Reedy fork of Reedy River, bounded S west by Paty Princes land all other sides vacant, and Hath such shape and Marks as the above Plat Represents, —
Recorded the 16th april 1785, —

Survey^d the 16th Dec^r 1784 —
by James Seaborn D^r.