



State of S^c Carolina / 96 dist: W of the ancient Boundary line,
 Pursuant to a warrant from John Thomas Esq^r Commissioner
 of Locations dated the 19th Oct^r 1784, I have admeasured and
 laid out unto Aquila Brasher a tract of land containing
 two hundred acres lying on the North side of Needy River
 on both sides of Stony Creek, bounded SW by Samuel
 Pile's land, all other sides Vacant Land,
 and hath such shape and Marks as the annexed
 Plat Represents, Survey^d 19th Jan^y 1785,
 by Andrew Thomson D^y

Recorded the 14th May 1785,

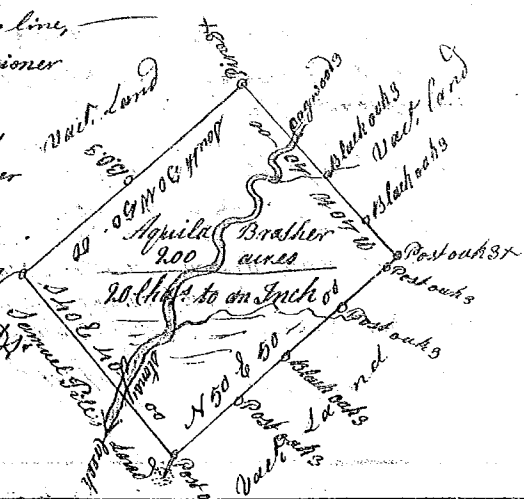

State of South Carolina Ninety Six District East of the ancient
 Boundary line Pursuant to a warrant from
 John Thomas Esq^r Commissioner of Locations
 Dated 3rd March 1785, I have admeasured and
 laid out unto Joel Hembree a tract of land
 containing four hundred and eighty acres,
 lying on both sides of Cain Creek a branch
 of Tyger River bounded westerly by land
 laid out to John Os Shields NW by land
 laid out to Daniel Hailer, N.E. by land laid
 out to Milington Smith & Samuel Kithcart
 Land, all other sides Vacant Land, and
 hath such shape and Marks as the a
 bove Plat represent,
 Survey^d the 16th March 1785,
 by And^r Thomson D^y

Recorded 14th May 1785,

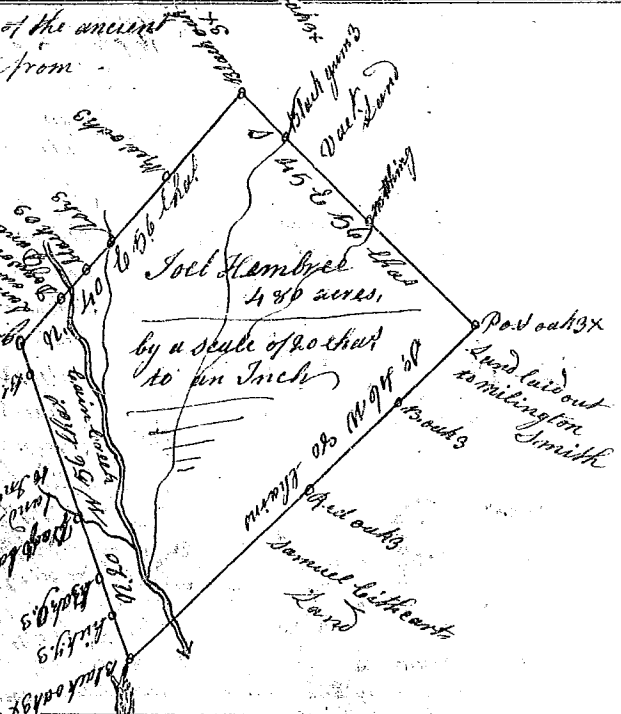

State of S^c Carolina / 96 District East of the ancient Boundary
 Pursuant to a warrant from John Thomas Esq^r
 Commissioner of Locations dated the 6th day of Feb^r 1785,
 I have admeasured and laid out unto
 William Poole a tract of land containing
 three hundred and eighty three acres
 situate lying and being on the south
 side of Lawson's fork bounded E & S
 by Joseph Burnett's Land N.W. by
 James Brown's land N.W. by
 land laid out for James M. Ekroy
 and Charles James, all other sides
 Vacant Land, and hath such shape
 and Marks as the above Plat
 Represents, Survey^d 31 March 1785,
 Andrew Thomson
 D^y

Recorded the 4th May 1785,

